

MISSISSIPPI DEPARTMENT OF ENVIRONMENTAL QUALITY

Office of Land and Water Resources

P. O. Box 10631
Jackson, MS 39289-0631
WATER WELL DRILLERS LOG

COUNTY WELL LOCATED <i>Jackson</i>	
WELL NUMBER <i>R 2466</i>	CODED
DATE WELL COMPLETED <i>9-3-95</i>	

PERMIT NUMBER *0408*

NAME OF DRILLING FIRM
Flytco 1/2 well serv.

194 Depot Rd

Lumbard MS 39452

NAME & MAILING ADDRESS OF LANDOWNER
Rayford Graham

P.O. Box 1855

Lumbard MS 39441-1855

WELL LOCATION	SEC	TOWNSHIP	RANGE
<i>24</i>	<i>T 6</i>	<i>N R 7 E</i>	

DISTANCE *3* Miles *East* of *Vanalena*

OTHER LANDMARK
Boat
3/4 mile S side of John's land

WELL PURPOSE (Home, Irrigation, Municipal, Industrial, Fish Pond, etc.)
thru

PUMP DATA

PUMP TYPE (Circle One):
 Submersible, Turbine, Jet, Flowing Well,
Other (Describe) _____

POWER TYPE (Circle One):
 Electric, Tractor, Diesel, Gasoline, Butane,
Other (Describe) _____ H/P *3/4*

Pump Capacity (GPM) <i>20</i>	No of Stages <i>12</i>	Setting Depth <i>60'</i>	FT.
----------------------------------	---------------------------	-----------------------------	-----

PUMP TEST

Well yielded *20* GPM with
a drawdown of *5* ft.
after *1 1/2* hours of pumping

WELL DATA

Well Depth <i>137'</i>	Casing Diameter (In) <i>4"</i>	Casing Length (Ft.) <i>127</i>
Type of Casing <i>PVC</i>	Hole Depth <i>137</i>	Depth to Static Water Level <i>40'</i>

TYPE OF COMPLETION: (Circle One or More):
 Gravel Packed, Underreamed, Telescoped,
 Natural Development, Open Hole, Other
(Describe) *air lift*

WELL GROUTED TO A DEPTH OF *137* FEET
Type Grout (circle one): Cement, Bentonite, or Mix

LOG DATA

TYPE OF LOG RUN (Circle One): No Log Run, Electric, Gamma Ray, Density, Sonic, Neutron,
Other (Describe) _____

Name of Organization Running Log

SCREEN DATA

Diameter - Inches <i>4"</i>	Length - Feet <i>10</i>	Slot Size - Inches <i># 8</i>
Screen Type <i>PVC Wrapped</i>	Depth to Bottom - Feet <i>137</i>	

GEOLOGIC DATA (Office Use Only)

Surface Elev.	Geologic Unit	Unit Thickness	Depth to Top
Subs. SWL	Date	Analysis	Aquifer Test

Driller's Remarks

Top of Lap Pipe or Reduction in Casing

IF TELESCOPED OR MORE THAN ONE SCREEN: USE BACK PAGE

DESCRIPTION OF FORMATIONS ENCOUNTERED	FROM	TO
<i>Top Soil</i>	<i>0</i>	<i>5</i>
<i>Sandy Clay</i>	<i>5</i>	<i>20</i>
<i>Clay</i>	<i>20</i>	<i>40</i>
<i>Sand</i>	<i>40</i>	<i>70</i>
<i>Sheeps Sand Clay</i>	<i>70</i>	<i>100</i>
<i>Sand</i>	<i>100</i>	<i>120</i>
<i>Sand</i>	<i>120</i>	<i>137</i>

FORM 1009 (Continued)

RECORDED


OCT 18 1995

Dept. of Environmental Quality
Office of Land & Water Resources

IF MORE SPACE IS NEEDED, USE BACK

If well telescopes please sketch and show depths.

GROUND LEVEL

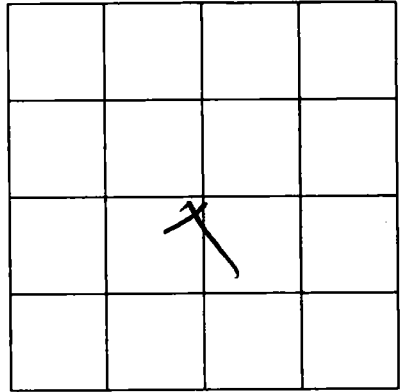

SECTION 24

Please indicate well location X.

ADDITIONAL INFORMATION

If more than one screen, show location of each on sketch.