

MISSISSIPPI DEPARTMENT OF ENVIRONMENTAL QUALITY

Office of Land and Water Resources

P. O. Box 10631

Jackson, MS 39289-0631

WATER WELL DRILLERS LOG

COUNTY WELL LOCATED
Jackson

WELL NUMBER CODED
K 2467

DATE WELL COMPLETED
8-9-95

PERMIT NUMBER
0408

NAME OF DRILLING FIRM.
Triple Well Ser.

154 Depot Rd

NAME & MAILING ADDRESS OF LANDOWNER
E. S. Morgan

4515 Lanier Ave

Pascagoula MS 39581

WELL LOCATION SEC TOWNSHIP RANGE
Sec 31 T6 N 87 E

DISTANCE DIRECTION NEAREST TOWN
3 1/2 Miles North of Vicksburg

OTHER LANDMARK
Old Blountain Road

WELL PURPOSE (Home Irrigation, Municipal, Industrial, Fish Pond, etc.)
hr

PUMP DATA

PUMP TYPE (Circle One):
Submersible, Turbine, Jet Flowing Well, Other (Describe) _____

POWER TYPE (Circle One):
Electric Tractor, Diesel, Gasoline, Butane, Other (Describe) _____ H/P _____

Pump Capacity (GPM) <i>10</i>	No. of Stages <i>2</i>	Setting Depth <i>80</i> FT.
----------------------------------	---------------------------	--------------------------------

PUMP TEST

Well yielded *8* GPM with a drawdown of *10* ft. after *1* hours of pumping

WELL DATA

Well Depth <i>120'</i>	Casing Diameter (In.) <i>2"</i>	Casing Length (Ft.) <i>110'</i>
Type of Casing <i>PVC</i>	Hole Depth <i>120'</i>	Depth to Static Water Level <i>68'</i>

LOG DATA

TYPE OF LOG RUN (Circle One):
No Log Run, Electric, Gamma Ray, Density, Sonic, Neutron, Other (Describe) _____

Name of Organization Running Log

TYPE OF COMPLETION: (Circle One or More):
Gravel Packed, Underreamed, Telescoped, Natural Development, Open Hole, Other (Describe) *air lift*

WELL GROUTED TO A DEPTH OF *20* FEET
Type Grout (circle one): Cement, Bentonite, or Mix

GEOLOGIC DATA (Office Use Only)

Surface Elev.	Geologic Unit	Unit Thickness	Depth to Top
Subs. SWL	Date	Analysis	Aquifer Test

SCREEN DATA

Diameter - Inches <i>2"</i>	Length - Feet <i>10</i>	Slot Size - Inches <i>#8</i>
Screen Type <i>PVC, Wrapped</i>	Depth to Bottom - Feet <i>120'</i>	

Driller's Remarks

Top of Lap Pipe or Reduction in Casing

FEET IF TELESCOPED OR MORE THAN ONE SCREEN: USE BACK PAGE

DESCRIPTION OF FORMATIONS ENCOUNTERED	FROM	TO
<i>Top Soil</i>	<i>0</i>	<i>5</i>
<i>Clay</i>	<i>5</i>	<i>20</i>
<i>Sandy Clay</i>	<i>20</i>	<i>40</i>
<i>Clay</i>	<i>40</i>	<i>60</i>
<i>Clay</i>	<i>60</i>	<i>100</i>
<i>Clay</i>	<i>100</i>	<i>120</i>


FORMATIONS (Continued)	FROM	TO

RECEIVED
OCT 18 1995
Dept. of Environmental Quality
Office of Land & Water Resources

IF MORE SPACE IS NEEDED, USE BACK

If well telescopes please sketch and show depths.

GROUND LEVEL

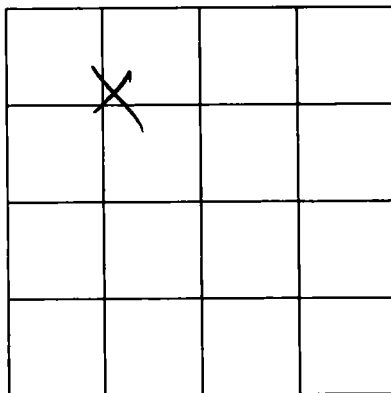

SECTION 31

Please indicate well location X.

ADDITIONAL INFORMATION

If more than one screen,
show location of each on sketch.