

**MISSISSIPPI DEPARTMENT OF ENVIRONMENTAL QUALITY**

Office of Land and Water Resources

P. O. Box 10631  
Jackson, MS 39289-0631

**WATER WELL DRILLERS LOG**

COUNTY WELL LOCATED <i>Jackson</i>	
WELL NUMBER <i>R 2473</i>	CODED
DATE WELL COMPLETED <i>10-5-95</i>	

PERMIT NUMBER
NAME OF DRILLING FIRM <i>Coast Water Well Service</i>

NAME & MAILING ADDRESS OF LANDOWNER <i>Wade Beech Clearwater Rd Vanceville Ms</i>		
WELL LOCATION: SEC	TOWNSHIP	RANGE
<i>26</i>	<i>6 S</i>	<i>7 E</i>
DISTANCE	DIRECTION	NEAREST TOWN
<i>3 1/2</i> Miles	<i>SSE</i>	of <i>Vanceville</i>
OTHER LANDMARK		
WELL PURPOSE: <input checked="" type="radio"/> Home, <input type="radio"/> Irrigation, <input type="radio"/> Municipal, <input type="radio"/> Industrial, <input type="radio"/> Fish Pond, etc.		

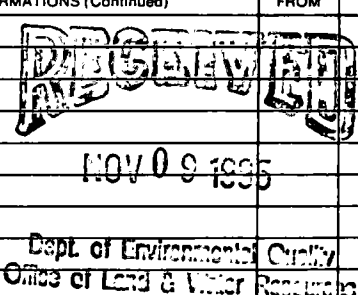
<b>PUMP DATA</b>		
PUMP TYPE (Circle One): Submersible, Turbine, <input checked="" type="radio"/> Jet, <input type="radio"/> Flowing Well, Other (Describe) _____		
POWER TYPE (Circle One): <input checked="" type="radio"/> Electric, <input type="radio"/> Tractor, <input type="radio"/> Diesel, <input type="radio"/> Gasoline, <input type="radio"/> Butane, Other (Describe) _____ H/P <i>1</i>		
Pump Capacity (GPM) <i>10</i>	No. of Stages <i>2</i>	Setting Depth  <b>FT.</b>
PUMP TEST		
Well yielded _____ GPM with a drawdown of _____ ft. after _____ hours of pumping		

<b>WELL DATA</b>		
Well Depth <i>398'</i>	Casing Diameter (In.) <i>2"</i>	Casing Length (Ft.) <i>398'</i>
Type of Casing <i>PVC</i>	Hole Depth <i>398'</i>	Depth to Static Water Level <i>30'</i>
TYPE OF COMPLETION: (Circle One or More): <input checked="" type="radio"/> Gravel Packed, <input type="radio"/> Underreamed, <input type="radio"/> Telescoped, <input checked="" type="radio"/> Natural Development, <input type="radio"/> Open Hole, <input type="radio"/> Other (Describe) _____		
WELL GROUTED TO A DEPTH OF <i>20</i> FEET Type Grout (circle one): <input checked="" type="radio"/> Cement, <input type="radio"/> Bentonite, or Mix		

<b>LOG DATA</b>	
TYPE OF LOG RUN (Circle One): Electric, Gamma Ray, Density, Sonic, Neutron, Other (Describe) _____ <i>No Log Run</i>	
Name of Organization Running Log	

<b>SCREEN DATA</b>		
Diameter - Inches <i>2"</i>	Length - Feet <i>10'</i>	Slot Size - Inches <i>.008</i>
Screen Type <i>PVC</i>	Depth to Bottom - Feet <i>398</i>	

<b>GEOLOGIC DATA (Office Use Only)</b>			
Surface Elev.	Geologic Unit	Unit Thickness	Depth to Top
Subs. SWL	Date	Analysis	Aquifer Test
Driller's Remarks			

DESCRIPTION OF FORMATIONS ENCOUNTERED	FROM	TO	FORMATIONS (Continued)	FROM	TO
<i>White Coarse sand</i>	<i>0</i>	<i>19</i>			
<i>Blue Clay</i>	<i>19</i>	<i>28</i>			
<i>White Coarse sand</i>	<i>28</i>	<i>55</i>			
<i>Shale Clay &amp; sand</i>	<i>55</i>	<i>147</i>			
<i>Blue Clay</i>	<i>147</i>	<i>384</i>			
<i>White Coarse sand</i>	<i>384</i>	<i>398</i>			

IF MORE SPACE IS NEEDED, USE BACK

If well telescopes please sketch and show depths.

GROUND LEVEL

X			

SECTION 26

Please indicate well location X.

ADDITIONAL INFORMATION

If more than one screen,  
show location of each on sketch.