

MISSISSIPPI DEPARTMENT OF ENVIRONMENTAL QUALITY

Office of Land and Water Resources

P. O. Box 10631
Jackson, MS 39289-0631
WATER WELL DRILLERS LOG

COUNTY WELL LOCATED
Jackson

WELL NUMBER CODED PERMIT NUMBER
R 2508

DATE WELL COMPLETED
10-9-96

NAME OF DRILLING FIRM
Coast Water Well Service

NAME & MAILING ADDRESS OF LANDOWNER
John Chapman
Old River Rd.
Vanleave, Ms

WELL LOCATION SEC TOWNSHIP RANGE
10 6 N 7 E

DISTANCE DIRECTION NEAREST TOWN
1 Miles *NE* of *Vanleave*

OTHER LANDMARK

WELL PURPOSE Home Irrigation, Municipal, Industrial, Fish Pond, etc.

PUMP DATA

PUMP TYPE (Circle One):
Submersible, Turbine, Jet, Flowing Well,
Other (Describe) _____

POWER TYPE (Circle One):
 Electric, Tractor, Diesel, Gasoline, Butane,
Other (Describe) _____ H/P

Pump Capacity (GPM) No. of Stages Setting Depth
8 *2* _____ FT.

PUMP TEST

Well yielded _____ GPM with
a drawdown of _____ ft.
after _____ hours of pumping

WELL DATA

Well Depth <i>302'</i>	Casing Diameter (In.) <i>2"</i>	Casing Length (Ft.) <i>282'</i>
Type of Casing <i>PVC</i>	Hole Depth <i>302'</i>	Depth to Static Water Level <i>65'</i>

TYPE OF COMPLETION: (Circle One or More):
 Gravel Packed, Underreamed, Telescoped,
 Natural Development, Open Hole, Other
(Describe) _____

WELL GROUTED TO A DEPTH OF *20* FEET
Type Grout (circle one): Cement, Bentonite, or Mix

LOG DATA

TYPE OF LOG RUN (Circle One):
Electric, Gamma Ray, Density, Sonic, No Log Run, Neutron,
Other (Describe) _____

Name of Organization Running Log

SCREEN DATA

Diameter - Inches <i>2"</i>	Length - Feet <i>10'</i>	Slot Size - Inches <i>.008</i>
Screen Type <i>PVC</i>	Depth to Bottom - Feet <i>302</i>	

GEOLOGIC DATA (Office Use Only)

Surface Elev.	Geologic Unit	Unit Thickness	Depth to Top
Subs. SWL	Date	Analysis	Aquifer Test

DESCRIPTION OF FORMATIONS ENCOUNTERED	FROM	TO	FORM. TEST. (Indicate)	FORM. TEST. (Indicate)	FORM. TEST. (Indicate)
<i>Top Soil</i>	<i>0</i>	<i>2</i>			
<i>Red Clay</i>	<i>2</i>	<i>15</i>			
<i>Med. Pink sand</i>	<i>15</i>	<i>24</i>			
<i>White Clay</i>	<i>24</i>	<i>65</i>			
<i>White Coarse sand</i>	<i>65</i>	<i>135</i>			
<i>Blue Clay</i>	<i>135</i>	<i>265</i>			
<i>Gray Coarse sand</i>	<i>265</i>	<i>292</i>			
<i>Gray coarse sand with</i>	<i>292</i>	<i>302</i>			

IF TELESOPED OR MORE THAN ONE SCREEN: USE BACK PAGE

RECEIVED


NOV 14 1996

Dept. of Environmental Quality
Office of Land & Water Resources

IF MORE SPACE IS NEEDED, USE BACK

If well telescopes please sketch and show depths.

GROUND LEVEL

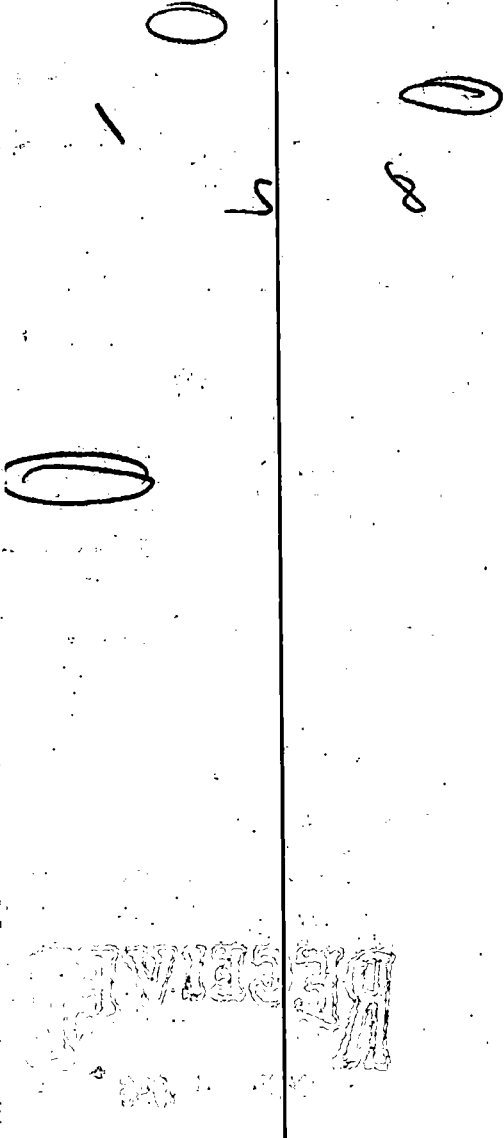

Handwritten notes:
Old well
my, ...
10
10
SECTION 10

Please indicate well location X.

ADDITIONAL INFORMATION

Lined area for additional information.

If more than one screen,
show location of each on sketch.