

**MISSISSIPPI DEPARTMENT OF ENVIRONMENTAL  
QUALITY**

Office of Land and Water Resources

P. O. Box 10631  
Jackson, MS 39289-0631  
**WATER WELL DRILLERS LOG**

|  |       |
|--|-------|
| COUNTY WELL LOCATED<br><i>Jackson</i>  |       |
| WELL NUMBER<br><i>R 2570</i>           | CODED |
| DATE WELL COMPLETED<br><i>10-17-96</i> |       |

|  |
|--|
| PERMIT NUMBER  |
| NAME OF DRILLING FIRM<br><i>Coast Water Well Service</i> |

|   |           |                    |              |
|---|-----------|--------------------|--------------|
| NAME & MAILING ADDRESS OF LANDOWNER<br><i>Billy Albair<br/>Johns Bayou Rd.<br/>Vancehue Ms</i>  |           |                    |              |
| WELL LOCATION   | SEC       | TOWNSHIP           | RANGE        |
|   | <i>4</i>  | <i>6</i>           | <i>N 7 E</i> |
| DISTANCE  | DIRECTION | NEAREST TOWN       |              |
| <i>3</i> Miles  | <i>SE</i> | of <i>Vancehue</i> |              |
| OTHER LANDMARK  |           |                    |              |
| WELL PURPOSE: <input checked="" type="radio"/> Home, <input type="radio"/> Irrigation, <input type="radio"/> Municipal, <input type="radio"/> Industrial, <input type="radio"/> Fish Pond, etc. |           |                    |              |

|  |                           |                            |
|--|---------------------------|----------------------------|
| <b>PUMP DATA</b>   |                           |                            |
| PUMP TYPE (Circle One):<br>Submersible, Turbine, <input checked="" type="radio"/> Jet, <input type="radio"/> Flowing Well,<br>Other (Describe) _____   |                           |                            |
| POWER TYPE (Circle One):<br><input checked="" type="radio"/> Electric, <input type="radio"/> Tractor, <input type="radio"/> Diesel, <input type="radio"/> Gasoline, <input type="radio"/> Butane,<br>Other (Describe) _____ H/P <i>1/2</i> |                           |                            |
| Pump Capacity (GPM)<br><i>8</i>  | No. of Stages<br><i>1</i> | Setting Depth<br>_____ FT. |
| PUMP TEST<br>Well yielded _____ GPM with<br>a drawdown of _____ ft.<br>after _____ hours of pumping  |                           |                            |

|                              |                                    |   |
|------------------------------|------------------------------------|---|
| <b>WELL DATA</b>             |                                    |   |
| Well Depth<br><i>60'</i>     | Casing Diameter (In.)<br><i>2"</i> | Casing Length (Ft.)<br><i>50'</i>         |
| Type of Casing<br><i>PVC</i> | Hole Depth<br><i>60'</i>           | Depth to Static Water Level<br><i>24'</i> |

|  |  |
|--|--|
| <b>LOG DATA</b>  |  |
| TYPE OF LOG RUN (Circle One):<br>Electric, Gamma Ray, Density, Sonic, Neutron,<br>Other (Describe) _____ <input checked="" type="radio"/> No Log Run |  |
| Name of Organization Running Log   |  |

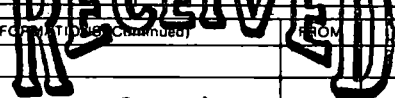
|   |  |  |  |
|---|--|--|--|
| TYPE OF COMPLETION: (Circle One or More):<br>Gravel Packed, <input checked="" type="radio"/> Underreamed, <input type="radio"/> Telescoped,<br><input checked="" type="radio"/> Natural Development, <input type="radio"/> Open Hole, <input type="radio"/> Other<br>(Describe) _____ |  |  |  |
|---|--|--|--|

|  |               |                |              |
|--|---------------|----------------|--------------|
| <b>GEOLOGIC DATA (Office Use Only)</b> |               |                |              |
| Surface Elev.                          | Geologic Unit | Unit Thickness | Depth to Top |
| Subs. SWL                              | Date          | Analysis       | Aquifer Test |

|   |
|---|
| WELL GROUTED TO A DEPTH OF <i>20</i> FEET<br>Type Grout (circle one): Cement, Bentonite, or Mix |
|---|

|  |
|--|
| Driller's Remarks                      |
| Top of Lap Pipe or Reduction in Casing |

|                                |                                      |                                   |
|--------------------------------|--------------------------------------|-----------------------------------|
| <b>SCREEN DATA</b>             |                                      |                                   |
| Diameter - Inches<br><i>2"</i> | Length - Feet<br><i>10'</i>          | Slot Size - Inches<br><i>.008</i> |
| Screen Type<br><i>PVC</i>      | Depth to Bottom - Feet<br><i>60'</i> |                                   |

|   |               |
|---|---------------|
| <br>NOV 14 1996<br>Dept. of Environmental Quality<br>Office of Land & Water Resources |               |
| FORM TIDW-100 (Continued)   | FORM TIDW-100 |
| FROM  | TO            |

| DESCRIPTION OF FORMATIONS ENCOUNTERED | FROM      | TO        |
|---------------------------------------|-----------|-----------|
| <i>Top Soil</i>                       | <i>0</i>  | <i>2</i>  |
| <i>gray yellow clay</i>               | <i>2</i>  | <i>15</i> |
| <i>pink coarse sand</i>               | <i>15</i> | <i>60</i> |
|                                       |           |           |
|                                       |           |           |
IF MORE SPACE IS NEEDED, USE BACK

If well telescopes please  
sketch and show depths.

GROUND LEVEL

|  |   |  |  |
|--|---|--|--|
|  | X |  |  |
|  |   |  |  |
|  |   |  |  |
|  |   |  |  |

SECTION 4

Please indicate well location X.

ADDITIONAL INFORMATION

If more than one screen,  
show location of each on sketch.