

MISSISSIPPI DEPARTMENT OF ENVIRONMENTAL QUALITY

Office of Land and Water Resources

P. O. Box 10631
Jackson, MS 39289-0631
WATER WELL DRILLERS LOG

COUNTY WELL LOCATED <i>Jackson</i>	
WELL NUMBER <i>K 2529</i>	CODED
DATE WELL COMPLETED <i>4-10-97</i>	

PERMIT NUMBER
NAME OF DRILLING FIRM <i>Coast Water Well Service</i>

NAME & MAILING ADDRESS OF LANDOWNER <i>Jim Stringfellow</i>			
<i>Patican Bayou Rd.</i>			
<i>Vandave, Ms</i>			
WELL LOCATION	SEC	TOWNSHIP	RANGE
	<i>13</i>	<i>6</i>	<i>7 E</i>
DISTANCE	DIRECTION	NEAREST TOWN	
<i>3</i> Miles	<i>SE</i>	of <i>VANLEAVE</i>	
OTHER LANDMARK			
WELL PURPOSE <input checked="" type="checkbox"/> Home Irrigation, <input type="checkbox"/> Municipal, <input type="checkbox"/> Industrial, <input type="checkbox"/> Fish Pond, etc.			

PUMP DATA		
PUMP TYPE (Circle One): Submersible, Turbine, <input checked="" type="radio"/> Jet, Flowing Well, Other (Describe) _____		
POWER TYPE (Circle One): <input checked="" type="radio"/> Electric, Tractor, Diesel, Gasoline, Butane, Other (Describe) _____ <i>H/P 1</i>		
Pump Capacity (GPM) <i>12</i>	No. of Stages <i>2</i>	Setting Depth FT.
PUMP TEST		
Well yielded _____ GPM with a drawdown of _____ ft. after _____ hours of pumping		

WELL DATA		
Well Depth <i>140'</i>	Casing Diameter (In.) <i>2"</i>	Casing Length (Ft.) <i>130'</i>
Type of Casing <i>PVC</i>	Hole Depth <i>140'</i>	Depth to Static Water Level <i>25'</i>

TYPE OF COMPLETION: (Circle One or More):
 Gravel Packed, Underreamed, Telescoped,
 Natural Development, Open Hole, Other
 (Describe) _____

WELL GROUTED TO A DEPTH OF *20* FEET
 Type Grout (circle one): Cement, Bentonite, or Mix

SCREEN DATA		
Diameter - Inches <i>2"</i>	Length - Feet <i>10'</i>	Slot Size - Inches <i>.008</i>
Screen Type <i>PVC</i>	Depth to Bottom - Feet <i>140'</i>	

LOG DATA	
TYPE OF LOG RUN (Circle One): Electric, Gamma Ray, Density, Sonic, <input checked="" type="radio"/> No Log Run, Neutron, Other (Describe) _____	
Name of Organization Running Log	

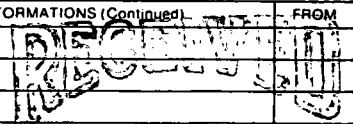
GEOLOGIC DATA (Office Use Only)			
Surface Elev.	Geologic Unit	Unit Thickness	Depth to Top
Subs. SWL	Date	Analysis	Aquifer Test

Driller's Remarks

Top of Lap Pipe or Reduction in Casing

FEET IF TELESCOPED OR MORE THAN ONE SCREEN: USE BACK PAGE

DESCRIPTION OF FORMATIONS ENCOUNTERED	FROM	TO
<i>Top Soil</i>	<i>0</i>	<i>2</i>
<i>wh. coarse sand & gravel</i>	<i>2</i>	<i>63</i>
<i>White Clay</i>	<i>63</i>	<i>81</i>
<i>White Med. sand</i>	<i>81</i>	<i>140</i>

FORMATIONS (Continued)	FROM	TO
 <i>JUL 21 1997</i>		
Dept. of Environmental Quality Office of Land & Water Resources		
IF MORE SPACE IS NEEDED, USE BACK		

If well telescopes please sketch and show depths.

GROUND LEVEL

Vertical line for sketching well telescopes and depths.

	X		

SECTION 13

Please indicate well location X.

ADDITIONAL INFORMATION

Lined area for additional information.

If more than one screen, show location of each on sketch.
