

**MISSISSIPPI DEPARTMENT OF ENVIRONMENTAL QUALITY**

Office of Land and Water Resources

P. O. Box 10631  
Jackson, MS 39289-0631  
**WATER WELL DRILLERS LOG**

COUNTY WELL LOCATED <i>Jackson</i>	
WELL NUMBER <i>R 2530</i>	CODED
DATE WELL COMPLETED <i>4-9-97</i>	

PERMIT NUMBER
NAME OF DRILLING FIRM <i>Coast Water Well Service</i>

NAME & MAILING ADDRESS OF LANDOWNER <i>Charles Veasey Old River Rd Vandevan, Ms</i>			
WELL LOCATION	SEC <i>10</i>	TOWNSHIP <i>6 S</i>	RANGE <i>7 E</i>
DISTANCE <i>1</i> Miles	DIRECTION <i>NE</i>	NEAREST TOWN <i>Vandevan</i>	
OTHER LANDMARK			
WELL PURPOSE <input checked="" type="checkbox"/> Home, <input type="checkbox"/> Irrigation, <input type="checkbox"/> Municipal, <input type="checkbox"/> Industrial, <input type="checkbox"/> Fish Pond, etc.			

PUMP DATA		
PUMP TYPE (Circle One): Submersible, Turbine, <input checked="" type="radio"/> Flowing Well, Other (Describe) _____		
POWER TYPE (Circle One): <input checked="" type="radio"/> Electric, Tractor, Diesel, Gasoline, Butane, Other (Describe) _____ <i>H/P 1</i>		
Pump Capacity (GPM) <i>8</i>	No. of Stages <i>2</i>	Setting Depth _____ FT.
PUMP TEST		
Well yielded _____ GPM with a drawdown of _____ ft. after _____ hours of pumping		

WELL DATA		
Well Depth <i>315'</i>	Casing Diameter (In ) <i>2"</i>	Casing Length (Ft.) <i>305'</i>
Type of Casing <i>PVC</i>	Hole Depth <i>315'</i>	Depth to Static Water Level <i>60'</i>

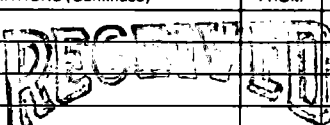
LOG DATA	
TYPE OF LOG RUN (Circle One): Electric, Gamma Ray, Density, <input checked="" type="radio"/> No Log Run, Sonic, Neutron, Other (Describe) _____	
Name of Organization Running Log	

TYPE OF COMPLETION: (Circle One or More): <input checked="" type="checkbox"/> Gravel Packed, <input type="checkbox"/> Underreamed, <input type="checkbox"/> Telescoped, <input checked="" type="checkbox"/> Natural Development, <input type="checkbox"/> Open Hole, <input type="checkbox"/> Other (Describe) _____			
WELL GROUTED TO A DEPTH OF <i>20</i> FEET Type Grout (circle one): Cement, <input checked="" type="checkbox"/> Bentonite, or Mix			

GEOLOGIC DATA (Office Use Only)			
Surface Elev.	Geologic Unit	Unit Thickness	Depth to Top
Subs. SWL	Date	Analysis	Aquifer Test

SCREEN DATA		
Diameter - Inches <i>2"</i>	Length - Feet <i>10'</i>	Slot Size - Inches <i>.008</i>
Screen Type <i>PVC</i>	Depth to Bottom - Feet <i>315'</i>	

Driller's Remarks	
Top of Lap Pipe or Reduction in Casing	
FEET	IF TELESCOPED OR MORE THAN ONE SCREEN: USE BACK PAGE

DESCRIPTION OF FORMATIONS ENCOUNTERED	FROM	TO	FORMATIONS (Continued)	FROM	TO
<i>Top Soil</i>	<i>0</i>	<i>2</i>	 <b>JUL 21 1997</b> Dept. of Environmental Quality Office of Land & Water Resources		
<i>Orange Pink Clay</i>	<i>2</i>	<i>12</i>			
<i>Med sand</i>	<i>12</i>	<i>20</i>			
<i>Gray Clay</i>	<i>20</i>	<i>40</i>			
<i>Med Coarse sand gravel</i>	<i>40</i>	<i>120</i>			
<i>Blue Clay streak sand</i>	<i>120</i>	<i>250</i>			
<i>Med Coarse sand</i>	<i>250</i>	<i>315</i>			

IF MORE SPACE IS NEEDED, USE BACK

