

MISSISSIPPI DEPARTMENT OF ENVIRONMENTAL QUALITY

Office of Land and Water Resources

P. O. Box 10631
Jackson, MS 39289-0631

WATER WELL DRILLERS LOG

COUNTY WELL LOCATED <i>Jackson</i>	
WELL NUMBER <i>R 2565</i>	CODED
DATE WELL COMPLETED <i>2-21-98</i>	

PERMIT NUMBER
NAME OF DRILLING FIRM <i>Coast Water Well Service</i>

NAME & MAILING ADDRESS OF LANDOWNER <i>Ernie Applewhite</i>			
<i>Ferry Point Rd.</i>			
<i>Gautier Ms</i>			
WELL LOCATION	SECT	TOWNSHIP	RANGE
	<i>38</i>	<i>6 S</i>	<i>7 E</i>
DISTANCE	DIRECTION	NEAREST TOWN	
<i>4</i> Miles	<i>SE</i>	of <i>Vanclave</i>	
OTHER LANDMARK			
WELL PURPOSE <input checked="" type="checkbox"/> Home <input type="checkbox"/> Irrigation, <input type="checkbox"/> Municipal, <input type="checkbox"/> Industrial, <input type="checkbox"/> Fish Pond, etc.			

PUMP DATA		
PUMP TYPE (Circle One): Submersible, Turbine, <input checked="" type="radio"/> Jet, Flowing Well, Other (Describe) _____		
POWER TYPE (Circle One): <input checked="" type="radio"/> Electric, Tractor, Diesel, Gasoline, Butane, Other (Describe) _____ H/P <i>1</i>		
Pump Capacity (GPM) <i>12</i>	No. of Stages <i>2</i>	Setting Depth FT.
PUMP TEST		
Well yielded _____ GPM with a drawdown of _____ ft. after _____ hours of pumping		

WELL DATA		
Well Depth <i>590'</i>	Casing Diameter (In.) <i>2"</i>	Casing Length (Ft) <i>580'</i>
Type of Casing <i>PVC</i>	Hole Depth <i>591'</i>	Depth to Static Water Level <i>25'</i>

LOG DATA	
TYPE OF LOG RUN (Circle One): Electric, Gamma Ray, Density, Sonic, <input checked="" type="radio"/> No Log Run, Neutron, Other (Describe) _____	
Name of Organization Running Log	

TYPE OF COMPLETION: (Circle One or More): <input checked="" type="checkbox"/> Gravel Packed, <input type="checkbox"/> Underreamed, <input type="checkbox"/> Telescoped, <input checked="" type="checkbox"/> Natural Development, <input type="checkbox"/> Open Hole, <input type="checkbox"/> Other (Describe) _____			
WELL GROUTED TO A DEPTH OF <i>20</i> FEET Type Grout (circle one): Cement, Bentonite, or Mix			

GEOLOGIC DATA (Office Use Only)			
Surface Elev.	Geologic Unit	Unit Thickness	Depth to Top
Subs. SWL	Date	Analysis	Aquifer Test

SCREEN DATA		
Diameter - Inches <i>2"</i>	Length - Feet <i>10'</i>	Slot Size - Inches <i>.004</i>
Screen Type <i>PVC wrapped</i>	Depth to Bottom - Feet <i>591'</i>	

Driller's Remarks	
Top of Lap Pipe or Reduction in Casing	
FEET	IF TELESCOPED OR MORE THAN ONE SCREEN: USE BACK PAGE


DESCRIPTION OF FORMATIONS ENCOUNTERED	FROM	TO	FORMATIONS (Continued)	FROM	TO
<i>Top Soil</i>	<i>0</i>	<i>2</i>	<i>Rock</i>	<i>-</i>	<i>360</i>
<i>Orange gray clay</i>	<i>2</i>	<i>40</i>	<i>Fine sand</i>	<i>525</i>	<i>535</i>
<i>Coarse sand</i>	<i>40</i>	<i>55</i>	<i>Blue Clay</i>	<i>535</i>	<i>578</i>
<i>Blue Clay</i>	<i>55</i>	<i>84</i>	<i>Med-Coarse sand</i>	<i>578</i>	<i>591</i>
<i>Med sand</i>	<i>84</i>	<i>100</i>			
<i>Blue Clay</i>	<i>100</i>	<i>120</i>			
<i>Med Coarse sand</i>	<i>120</i>	<i>155</i>			
<i>Blue Clay</i>	<i>155</i>	<i>275</i>			
<i>Med sand</i>	<i>275</i>	<i>285</i>			
<i>Blue Clay th. sand</i>	<i>285</i>	<i>525</i>			
<i>Rock</i>	<i>58</i>	<i>355</i>			

03-30-98A09:54 R.C.V.D.

IF MORE SPACE IS NEEDED, USE BACK

If well telescopes please sketch and show depths.

GROUND LEVEL

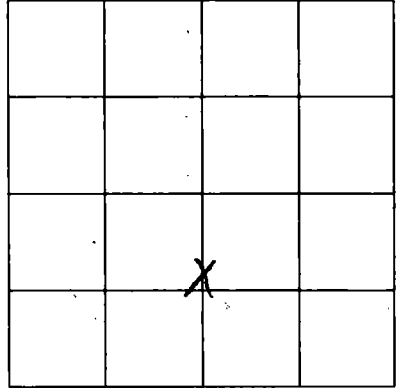

SECTION 38

Please indicate well location X.

ADDITIONAL INFORMATION

If more than one screen, show location of each on sketch.