

MISSISSIPPI DEPARTMENT OF ENVIRONMENTAL QUALITY

Office of Land and Water Resources

P. O. Box 10631
Jackson, MS 39289-0631
WATER WELL DRILLERS LOG

COUNTY WELL LOCATED <i>Jackson</i>	
WELL NUMBER <i>K 2592</i>	CODED
DATE WELL COMPLETED <i>3-16-99</i>	

PERMIT NUMBER
NAME OF DRILLING FIRM <i>Coastwater Well Service</i>

NAME & MAILING ADDRESS OF LANDOWNER <i>Connie Helms Russell Lane Vanceville, MS</i>		
WELL LOCATION: SEC	TOWNSHIP	RANGE
<i>29</i>	<i>6^N</i>	<i>7^W</i>
DISTANCE	DIRECTION	NEAREST TOWN
<i>2</i> Miles	<i>South</i>	<i>Vanceville</i>
OTHER LANDMARK		
WELL PURPOSE: <input checked="" type="checkbox"/> Home Irrigation, Municipal, Industrial, Fish Pond, etc.		

PUMP DATA		
PUMP TYPE (Circle One): Submersible, Turbine, <input checked="" type="radio"/> Jet, Flowing Well, Other (Describe) _____		
POWER TYPE (Circle One): <input checked="" type="radio"/> Electric, Tractor, Diesel, Gasoline, Butane, Other (Describe) _____ H/P <i>1</i>		
Pump Capacity (GPM) <i>8</i>	No. of Stages <i>2</i>	Setting Depth _____ FT.
PUMP TEST Well yielded _____ GPM with a drawdown of _____ ft. after _____ hours of pumping		

WELL DATA		
Well Depth <i>170'</i>	Casing Diameter (In.) <i>2"</i>	Casing Length (Ft.) <i>160'</i>
Type of Casing <i>PVC</i>	Hole Depth <i>170'</i>	Depth to Static Water Level <i>40</i>
TYPE OF COMPLETION: (Circle One or More): <input checked="" type="checkbox"/> Gravel Packed, <input type="checkbox"/> Underreamed, <input type="checkbox"/> Telescoped, <input checked="" type="checkbox"/> Natural Development, <input type="checkbox"/> Open Hole, <input type="checkbox"/> Other (Describe) _____		
WELL GROUTED TO A DEPTH OF <i>20</i> FEET Type Grout (circle one): <input checked="" type="radio"/> Cement, <input type="radio"/> Bentonite, or Mix		

LOG DATA	
TYPE OF LOG RUN (Circle One): Electric, Gamma Ray, Density, Sonic, <input checked="" type="radio"/> Neutron, Other (Describe) _____	
Name of Organization Running Log	

SCREEN DATA		
Diameter - Inches <i>2"</i>	Length - Feet <i>10'</i>	Slot Size - Inches <i>.008</i>
Screen Type <i>PVC</i>		Depth to Bottom - Feet <i>170'</i>

GEOLOGIC DATA (Office Use Only)			
Surface Elev.	Geologic Unit	Unit Thickness	Depth to Top
Subs. SWL	Date	Analysis	Aquifer Test
Driller's Remarks			

DESCRIPTION OF FORMATIONS ENCOUNTERED	FROM	TO
<i>Top Soil</i>	<i>0</i>	<i>2</i>
<i>Blue Clay</i>	<i>2</i>	<i>90</i>
<i>White Coarsesand</i>	<i>90</i>	<i>120</i>
<i>Blue Clay</i>	<i>120</i>	<i>122</i>
<i>White Coarsesand</i>	<i>122</i>	<i>170</i>


RECEIVED

APR 12 1999

Dept. of Environmental Quality
Office of Land & Water Resources

If well telescopes please sketch and show depths.

GROUND LEVEL

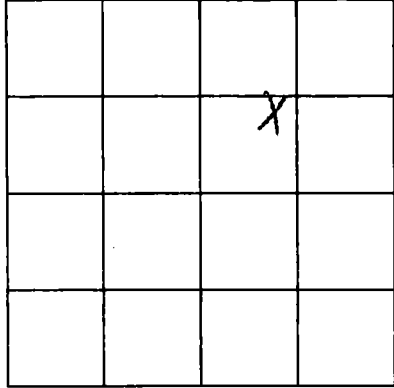

SECTION 29

Please indicate well location X.

ADDITIONAL INFORMATION

Lined area for additional information.

If more than one screen, show location of each on sketch.