

**MISSISSIPPI DEPARTMENT OF ENVIRONMENTAL QUALITY**  
Office of Land and Water Resources

P. O. Box 10631  
Jackson, MS 39289-0631  
**WATER WELL DRILLERS LOG**

COUNTY WELL LOCATED <i>Jackson</i>	
WELL NUMBER <i>R2615</i>	CODED
DATE WELL COMPLETED <i>6-4-99</i>	

PERMIT NUMBER
NAME OF DRILLING FIRM <i>Coastal Water Well Service</i>

NAME & MAILING ADDRESS OF LANDOWNER <i>Ricky Manning</i> <i>Mount Pleasant Rd.</i> <i>Vandeventer, Mo</i>			
WELL LOCATION	SEC	TOWNSHIP	RANGE
	<i>12</i>	<i>6</i>	<i>7E</i>
DISTANCE	DIRECTION	NEAREST TOWN	
<i>2 1/2</i> Miles	<i>East</i>	of <i>Vandeventer</i>	
OTHER LANDMARK			
WELL PURPOSE <input checked="" type="checkbox"/> Home, Irrigation, Municipal, Industrial, Fish Pond, etc.			

PUMP DATA		
PUMP TYPE (Circle One): Submersible, Turbine, <input checked="" type="radio"/> Jet, Flowing Well, Other (Describe) _____		
POWER TYPE (Circle One): <input checked="" type="radio"/> Electric, Tractor, Diesel, Gasoline, Butane, Other (Describe) _____ H/P <i>2</i>		
Pump Capacity (GPM) <i>8</i>	No of Stages <i>3</i>	Setting Depth _____ FT.
PUMP TEST		
Well yielded _____ GPM with a drawdown of _____ ft. after _____ hours of pumping		

WELL DATA		
Well Depth <i>225'</i>	Casing Diameter (In.) <i>2"</i>	Casing Length (Ft.) <i>215'</i>
Type of Casing <i>PVC</i>	Hole Depth <i>225'</i>	Depth to Static Water Level <i>100'</i>
TYPE OF COMPLETION (Circle One or More): <input checked="" type="checkbox"/> Gravel Packed, <input type="checkbox"/> Underreamed, <input type="checkbox"/> Telescoped, <input checked="" type="checkbox"/> Natural Development, <input type="checkbox"/> Open Hole, <input type="checkbox"/> Other (Describe) _____		

LOG DATA	
TYPE OF LOG RUN (Circle One): Electric, Gamma Ray, Density, Sonic, <input checked="" type="radio"/> No Log Run, Other (Describe) _____	
Name of Organization Running Log	

WELL GROUTED TO A DEPTH OF <i>20</i> FEET
Type Grout (circle one): <input checked="" type="radio"/> Cement, <input type="radio"/> Bentonite, or Mix

GEOLOGIC DATA (Office Use Only)			
Surface Elev	Geologic Unit	Unit Thickness	Depth to Top
Subs. SWL	Date	Analysis	Aquifer Test
Driller's Remarks			
Top of Lap Pipe or Reduction in Casing			
FEET	IF TELESCOPED OR MORE THAN ONE SCREEN: USE BACK PAGE		


SCREEN DATA		
Diameter - Inches <i>2"</i>	Length - Feet <i>10'</i>	Slot Size - Inches <i>.008</i>
Screen Type <i>PVC</i>	Depth to Bottom - Feet <i>225'</i>	

DESCRIPTION OF FORMATIONS ENCOUNTERED	FROM	TO
<i>Top Soil</i>	<i>0</i>	<i>2</i>
<i>Brown Clay</i>	<i>2</i>	<i>30</i>
<i>White Coarse sand</i>	<i>30</i>	<i>50</i>
<i>Blue Clay</i>	<i>50</i>	<i>80</i>
<i>White coarse sand</i>	<i>80</i>	<i>100</i>
<i>Blue Clay</i>	<i>100</i>	<i>101</i>
<i>White coarse sand</i>	<i>101</i>	<i>145</i>
<i>Blue Clay &amp; sand</i>	<i>145</i>	<i>210</i>
<i>gray-coarse sand</i>	<i>210</i>	<i>225</i>

FORMATIONS (Continued)		FROM	TO
<b>RECEIVED</b>			
JUL 09 1999			
Dept. of Environmental Quality Office of Land & Water Resource			
IF MORE SPACE IS NEEDED, USE BACK			

If well telescopes please sketch and show depths.

GROUND LEVEL

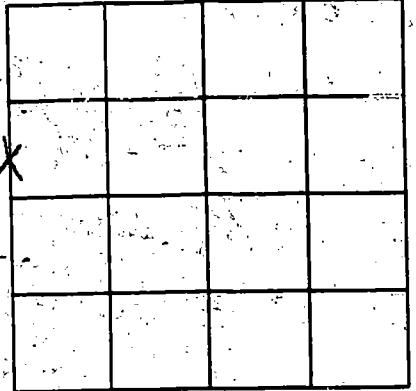

SECTION 12

Please indicate well location X.

ADDITIONAL INFORMATION

RECEIVED

M 0 2 1988

Office of Land & Water Resources  
Dept. of Environmental Quality

If more than one screen,  
show location of each on sketch.