

Office of Land and Water Resources

P. O. Box 10631

Jackson, MS 39289-0631

WATER WELL DRILLERS LOG

COUNTY WELL LOCATED		MISSISSIPPI D	
JACKSON			
WELL NUMBER	CODING	PERMIT NUMBER	
K 2639			
		NAME OF DRILLING FIRM	
		Coast Water Well	
DATE WELL COMPLETED		Service	
10-28-99			

NAME & MAILING ADDRESS OF LANDOWNER

John Jenkins
Jim Ramsey Rd
Vandervee, Mo.

WELL LOCATION: SEC TOWNSHIP RANGE

7 6 N 7 W

DISTANCE DIRECTION NEAREST TOWN

2 Miles West of Vandervee

OTHER LANDMARK

WELL PURPOSE: Home, Irrigation, Municipal, Industrial, Fish Pond, etc.

PUMP DATA		
PUMP TYPE (Circle One):		
Submersible, _____	Turbine, _____	<div style="border: 1px solid black; border-radius: 50%; padding: 2px; display: inline-block;">Jet</div>
Other (Describe) _____		
POWER TYPE (Circle One):		
<div style="border: 1px solid black; border-radius: 50%; padding: 2px; display: inline-block;">Electric</div>	Tractor, _____	Diesel, _____
Other (Describe) _____		Gasoline, _____
		Butane, _____
		H/P 2
Pump Capacity (GPM) <div style="font-size: 2em; margin-top: 10px;">9</div>	No. of Stages <div style="font-size: 2em; margin-top: 10px;">3</div>	Setting Depth <div style="text-align: right; margin-top: 10px;">FT.</div>
PUMP TEST		
Well yielded _____ GPM with		
a drawdown of _____ ft.		
after _____ hours of pumping		

WELL DATA		
Well Depth 320'	Casing Diameter (in.) 2"	Casing Length (ft.) 310'
Type of Casing PVC	Hole Depth 320'	Depth to Static Water Level 80'
TYPE OF COMPLETION: (Circle One or More):		
<input checked="" type="checkbox"/> Gravel Packed.	<input type="checkbox"/> Underreamed.	<input type="checkbox"/> Telescoped.
<input checked="" type="checkbox"/> Natural Development.	<input type="checkbox"/> Open Hole.	<input type="checkbox"/> Other
(Describe) _____		
WELL GROUTED TO A DEPTH OF 20 FEET		
Type Grout (circle one): Cement, Bentonite, or Mix		

LOG DATA

TYPE OF LOG RUN (Circle One): No Log Run

Electric, Gamma Ray, Density, Sonic, Neutron,
Other (Describe) _____

Name of Organization Running Log _____


SCREEN DATA		
Diameter - Inches 2"	Length - Feet 10'	Slot Size - Inches .008
Screen Type PVC		Depth to Bottom - Feet 320'

GEOLOGIC DATA (Office Use Only)			
Surface Elev.	Geologic Unit	Unit Thickness	Depth to Top
Subs. SWL	Date	Analysis	Aquifer Test
Driller's Remarks			
Top of Lap Pipe or Reduction in Casing			
FEET		IF TELESCOPED OR MORE THAN ONE SCREEN: USE BACK PAGE	

[illegible]

If well telescopes please
sketch and show depths.

GROUND LEVEL

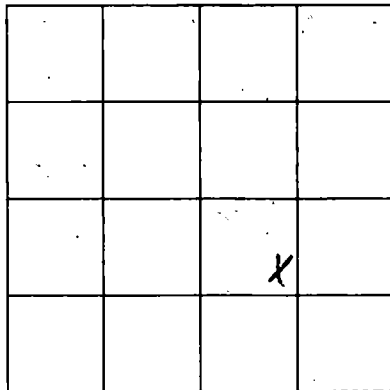

SECTION

7

Please indicate well location X.

ADDITIONAL INFORMATION

If more than one screen,
show location of each on sketch.