

**MISSISSIPPI DEPARTMENT OF ENVIRONMENTAL QUALITY**  
Office of Land and Water Resources

P. O. Box 10631  
Jackson, MS 39289-0631  
**WATER WELL DRILLERS LOG**

COUNTY WELL LOCATED <i>Jackson</i>	
WELL NUMBER <i>K 2670</i>	CODED
DATE WELL COMPLETED <i>3-1-2000</i>	

PERMIT NUMBER
NAME OF DRILLING FIRM <i>Coast Water Well Service</i>

NAME & MAILING ADDRESS OF LANDOWNER <i>Stere Nguyen</i>			
<i>Goin Country</i>			
<i>Vandeventer, Ms</i>			
WELL LOCATION	SEC	TOWNSHIP	RANGE
	<i>8</i>	<i>6 S</i>	<i>7 W</i>
DISTANCE <i>1 1/2</i> Miles	DIRECTION <i>West</i>	NEAREST TOWN <i>Vandeventer</i>	
OTHER LANDMARK			
WELL PURPOSE <input checked="" type="checkbox"/> Home <input type="checkbox"/> Irrigation <input type="checkbox"/> Municipal <input type="checkbox"/> Industrial <input type="checkbox"/> Fish Pond, etc.			

<b>PUMP DATA</b>		
PUMP TYPE (Circle One): <input checked="" type="radio"/> Submersible <input type="radio"/> Turbine <input checked="" type="radio"/> Flowing Well Other (Describe) _____		
POWER TYPE (Circle One): <input checked="" type="radio"/> Electric <input type="radio"/> Tractor <input type="radio"/> Diesel <input type="radio"/> Gasoline <input type="radio"/> Butane Other (Describe) _____ H/P <i>1 1/2</i>		
Pump Capacity (GPM) <i>20</i>	No of Stages <i>10</i>	Setting Depth <i>160</i> FT.
PUMP TEST		
Well yielded _____ GPM with		
a drawdown of _____ ft.		
after _____ hours of pumping		

<b>WELL DATA</b>		
Well Depth <i>330'</i>	Casing Diameter (In ) <i>4x2</i>	Casing Length (Ft) <i>240x4 70x2"</i>
Type of Casing <i>PVC</i>	Hole Depth <i>330'</i>	Depth to Static Water Level <i>95'</i>
TYPE OF COMPLETION: (Circle One or More): <input type="checkbox"/> Gravel Packed <input type="checkbox"/> Underreamed <input type="checkbox"/> Telescoped <input checked="" type="checkbox"/> Natural Development <input type="checkbox"/> Open Hole <input type="checkbox"/> Other		
(Describe) _____		
WELL GROUTED TO A DEPTH OF <i>20</i> FEET		
Type Grout (circle one): Cement <input type="checkbox"/> Bentonite <input type="checkbox"/> or Mix		

<b>LOG DATA</b>	
TYPE OF LOG RUN (Circle One): <input checked="" type="radio"/> No Log Run <input type="radio"/> Electric <input type="radio"/> Gamma Ray <input type="radio"/> Density <input type="radio"/> Sonic <input type="radio"/> Neutron Other (Describe) _____	
Name of Organization Running Log	

<b>SCREEN DATA</b>		
Diameter - inches <i>2"</i>	Length - Feet <i>20'</i>	Slot Size - inches <i>.008</i>
Screen Type <i>PVC</i>	Depth to Bottom - Feet <i>330'</i>	


<b>GEOLOGIC DATA (Office Use Only)</b>			
Surface Elev	Geologic Unit	Unit Thickness	Depth to Top
Subs SWL	Date	Analysis	Aquifer Test
Driller's Remarks			
Top of Log Pipe of Reflection in Casing			
FEET IF TELESCOPED OR MORE THAN ONE SCREEN; USE BACK PAGE			

DESCRIPTION OF FORMATIONS ENCOUNTERED	FORMATIONS (Continued)		FROM	TO
	DATE	TIME		
<i>Top Soil</i>	<i>3-1-2000</i>		<i>0</i>	<i>3</i>
<i>Red Clay</i>			<i>3</i>	<i>15</i>
<i>Med. Sand</i>			<i>15</i>	<i>25</i>
<i>Gray Clay</i>			<i>25</i>	<i>115</i>
<i>Coarse sand &amp; gravel</i>			<i>115</i>	<i>170</i>
<i>gray clay</i>			<i>170</i>	<i>180</i>
<i>purple sand</i>			<i>180</i>	<i>193</i>
<i>Blue clay &amp; s. sand</i>			<i>193</i>	<i>293</i>
<i>Med coarse sand</i>			<i>293</i>	<i>330</i>

IF MORE SPACE IS NEEDED, USE BACK

Dept. of Environmental Quality  
Office of Land & Water Resources

If well telescopes please sketch and show depths.

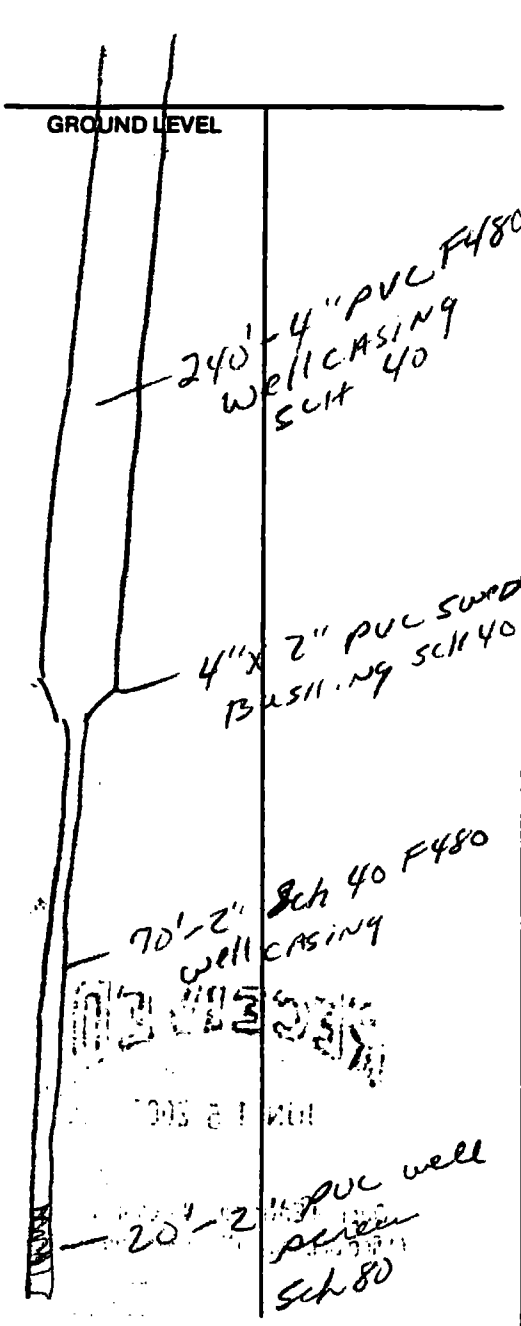

	X		

SECTION 8

Please indicate well location X.

ADDITIONAL INFORMATION

---

---

If more than one screen, show location of each on sketch.