

MISSISSIPPI DEPARTMENT OF ENVIRONMENTAL QUALITY

Office of Land and Water Resources

P. O. Box 10631

Jackson, MS 39289-0631

WATER WELL DRILLERS LOG

WELL LOCATED <i>Jackson</i>	
WELL NUMBER <i>K-2702</i>	CODED
DATE WELL COMPLETED <i>9-19-88</i>	

PERMIT NUMBER
NAME OF DRILLING FIRM <i>Coast Water Well Service</i>

NAME & MAILING ADDRESS OF LANDOWNER <i>Jerry Franco</i> <i>Little Bluffs</i> <i>Vandeventer, Mo.</i>			
WELL LOCATION	SEC <i>7</i>	TOWNSHIP <i>6 N</i>	RANGE <i>7 E</i>
DISTANCE <i>2 1/2</i>	DIRECTION <i>West</i>	NEAREST TOWN <i>Vandeventer</i>	
OTHER LANDMARK			
WELL PURPOSE <input checked="" type="checkbox"/> Home, <input type="checkbox"/> Irrigation, <input type="checkbox"/> Municipal, <input type="checkbox"/> Industrial, <input type="checkbox"/> Fish Pond, etc.			

PUMP DATA		
PUMP TYPE (Circle One): Submersible, Turbine, <input checked="" type="radio"/> Jet, Flowing Well, Other (Describe) _____		
POWER TYPE (Circle One): Electric, Tractor, Diesel, Gasoline, Butane, Other (Describe) _____ H/P <i>2</i>		
Pump Capacity (GPM) <i>6.5</i>	No of Stages <i>3</i>	Setting Depth _____ FT.
PUMP TEST		
Well yielded _____ GPM with a drawdown of _____ ft. after _____ hours of pumping		

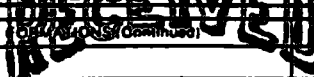
WELL DATA		
Well Depth <i>297'</i>	Casing Diameter (in) <i>2"</i>	Casing Length (ft) <i>287'</i>
Type of Casing <i>PVC</i>	Hole Depth <i>297'</i>	Depth to Static Water Level <i>105'</i>
TYPE OF COMPLETION: (Circle One or More): <input checked="" type="checkbox"/> Gavel Packed, <input type="checkbox"/> Underreamed, <input type="checkbox"/> Telescoped, <input checked="" type="checkbox"/> Natural Development, <input type="checkbox"/> Open Hole, <input type="checkbox"/> Other (Describe) _____		
WELL GROUTED TO A DEPTH OF <i>20</i> FEET Type Grout (circle one): Cement, <input checked="" type="radio"/> Bentonite or Mix		

LOG DATA	
TYPE OF LOG RUN (Circle One): Electric, Gamma Ray, Density, Sonic, Neutron, Other (Describe) _____	
Name of Organization Running Log	

SCREEN DATA		
Diameter - inches <i>2"</i>	Length - Feet <i>10'</i>	Slot Size - inches <i>.004</i>
Screen Type <i>PVC</i>	Depth to Bottom - Feet <i>297'</i>	

GEOLOGIC DATA (Office Use Only)			
Surface Elev	Geologic Unit	Unit Thickness	Depth to Top
Subs SWL	Date	Analysis	Aquifer Test
Order's Remarks			
Top of Lap Pipe or Reduction in Casing			
IF TELESCOPED OR MORE THAN 5 FEET LONG, ATTACH BACK PAGE			

DESCRIPTION OF FORMATIONS ENCOUNTERED	FROM	TO
Top Soil	0	2
Orange Clay	2	30
White Coarse Sand	30	130
Blue Clay	130	286
Medium to Coarse Sand	286	297

<div style="text-align: center;">  JAN 09 2001 Dept. of Environmental Quality Office of Land & Water Resources </div>	
IF MORE SPACE IS NEEDED, USE BACK	

If well telescopes please
sketch and show depths.

GROUND LEVEL

SECTION 7

Please indicate well location X.

ADDITIONAL INFORMATION

RECEIVED

U.S. DEPARTMENT OF THE INTERIOR
BUREAU OF LAND MANAGEMENT

If more than one screen.