

MISSISSIPPI DEPARTMENT OF ENVIRONMENTAL QUALITY
Office of Land and Water Resources

P. O. Box 10631
 Jackson, MS 39289-0631
WATER WELL DRILLERS LOG

COUNTY WELL LOCATED
Jackson
 WELL NUMBER K-2707 CODED _____
 DATE WELL COMPLETED
9-28-60

PERMIT NUMBER _____
 NAME OF DRILLING FIRM
Coast Water Well Service

NAME & MAILING ADDRESS OF LANDOWNER
Lloyd Sims
Jimi Ramsey Rd.
Vanclave, Ms.
 WELL LOCATION: SEC 7 TOWNSHIP 6^N RANGE 7^W
 DISTANCE 2 1/2 Miles DIRECTION West of NEAREST TOWN Vanclave
 OTHER LANDMARK _____
 WELL PURPOSE Home Irrigation, Municipal, Industrial, Fish Pond, etc.

PUMP DATA

PUMP TYPE (Circle One):
 Submersible, Turbine, Jet, Flowing Well,
 Other (Describe) _____
 POWER TYPE (Circle One):
 Electric, Tractor, Diesel, Gasoline, Butane,
 Other (Describe) _____ H/P 1
 Pump Capacity (GPM) 10 No. of Stages 10 Setting Depth 160' FT.
 PUMP TEST
 Well yielded _____ GPM with
 a drawdown of _____ ft.
 after _____ hours of pumping

WELL DATA

Well Depth 402' Casing Diameter (In.) 4"-2" Casing Length (Ft.) 385'
 Type of Casing PVC Hole Depth 402' Depth to Static Water Level 100'

LOG DATA

TYPE OF LOG RUN (Circle One):
 No Log Run, Electric, Gamma Ray, Density, Sonic, Neutron,
 Other (Describe) _____
 Name of Organization Running Log _____

TYPE OF COMPLETION: (Circle One or More):
 Gravel Packed, Underreamed, Telescoped,
 Natural Development, Open Hole, Other
 (Describe) _____
WELL GROUTED TO A DEPTH OF 20 FEET
 Type Grout (circle one): Cement, Bentonite, or Mix

GEOLOGIC DATA (Office Use Only)

Surface Elev.	Geologic Unit	Unit Thickness	Depth to Top
Subs. SWL	Date	Analysis	Aquifer Test

SCREEN DATA

Diameter - Inches 2" Length - Feet 17' Slot Size - Inches .008
 Screen Type PVC Depth to Bottom - Feet 402

Driller's Remarks _____

 Top of Lap Pipe or Reduction in Casing
 FEET IF TELESCOPED OR MORE THAN ONE SCREEN: USE BACK PAGE

DESCRIPTION OF FORMATIONS ENCOUNTERED	FROM	TO
TOP SOIL	0	2
Orange Clay	2	21
White Coarse Sand	21	63
Orange-White Clay	63	125
White Coarse Sand	125	150
Blue Clay	150	365
Coarse Sand	365	380
Blue Clay	380	384
Coarse Sand	384	402

RECEIVED


JAN 09 2001

Dept. of Environmental Quality
 Office of Land & Water Resources

IF MORE SPACE IS NEEDED, USE BACK

If well telescopes please sketch and show depths.

GROUND LEVEL

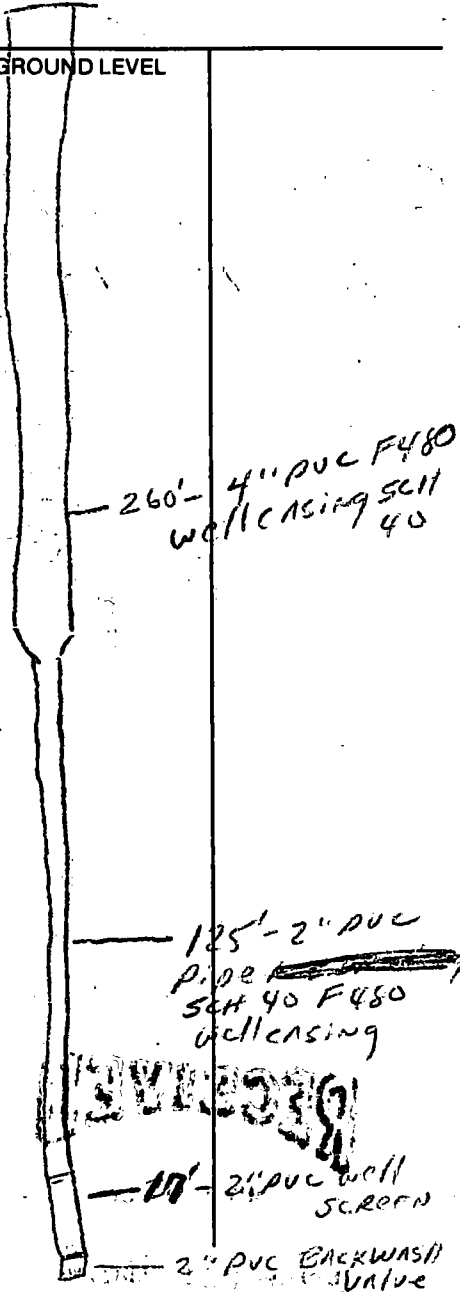

X			

SECTION 7

Please indicate well location X.

ADDITIONAL INFORMATION

If more than one screen, show location of each on sketch.