

MISSISSIPPI DEPARTMENT OF ENVIRONMENTAL QUALITY
Office of Land and Water Resources

P. O. Box 10631
Jackson, MS 39289-0631
WATER WELL DRILLERS LOG

COUNTY WELL LOCATED Jackson	
WELL NUMBER K-2724	CODED
DATE WELL COMPLETED 1-26-01	

PERMIT NUMBER
NAME OF DRILLING FIRM Coast Water Well Service

NAME & MAILING ADDRESS OF LANDOWNER Diane Willis			
Pinewood Hills			
Vanderveer Ms.			
WELL LOCATION	SEC	TOWNSHIP	RANGE
	19	6 S	7 E
DISTANCE	DIRECTION	NEAREST TOWN	
3 Miles	SW	of Vanderveer	
OTHER LANDMARK			
WELL PURPOSE: <input checked="" type="checkbox"/> Home, <input type="checkbox"/> Irrigation, <input type="checkbox"/> Municipal, <input type="checkbox"/> Industrial, <input type="checkbox"/> Fish Pond, etc.			

PUMP DATA		
PUMP TYPE (Circle One): Submersible, Turbine, <input checked="" type="radio"/> Jet, Flowing Well, Other (Describe) _____		
POWER TYPE (Circle One): <input checked="" type="radio"/> Electric, Tractor, Diesel, Gasoline, Butane, Other (Describe) _____ H/P 2		
Pump Capacity (GPM)	No. of Stages	Setting Depth
8	3	_____ FT.
PUMP TEST		
Well yielded _____ GPM with a drawdown of _____ ft. after _____ hours of pumping		

WELL DATA		
Well Depth	Casing Diameter (In.)	Casing Length (Ft.)
370'	2"	360'
Type of Casing	Hole Depth	Depth to Static Water Level
PVC	370	100'

LOG DATA	
TYPE OF LOG RUN (Circle One): Electric, Gamma Ray, Density, Sonic, Neutron, Other (Describe) _____	
Name of Organization Running Log	

TYPE OF COMPLETION: (Circle One or More):			
<input checked="" type="checkbox"/> Gravel Packed	<input type="checkbox"/> Underreamed,	<input type="checkbox"/> Telescoped,	<input type="checkbox"/> Other
<input checked="" type="checkbox"/> Natural Development, (Describe) _____	<input type="checkbox"/> Open Hole,		

GEOLOGIC DATA (Office Use Only)			
Surface Elev.	Geologic Unit	Unit Thickness	Depth to Top
Subs. SWL	Date	Analysis	Aquifer Test

WELL GROUTED TO A DEPTH OF 10 FEET
Type Grout (circle one): Cement, <input checked="" type="radio"/> Bentonite, or Mix

Driller's Remarks	
Top of Lap Pipe or Reduction in Casing	
FEET	IF TELESCOPED OR MORE THAN ONE SCREEN: USE BACK PAGE


SCREEN DATA		
Diameter - Inches	Length - Feet	Slot Size - Inches
2"	10'	.008
Screen Type	Depth to Bottom - Feet	
PVC	370'	

DESCRIPTION OF FORMATIONS ENCOUNTERED	FROM	TO	FORMATIONS (Continued)	FROM	TO
TOP SOIL	0	2			
Orange Clay Str. of Sand	2	100			
White coarse Sand	100	190			
Blue Clay	190	320			
Medium + Coarse Sand	320	370			

REC'D MAY 17 2001

If well telescopes please
sketch and show depths.

GROUND LEVEL

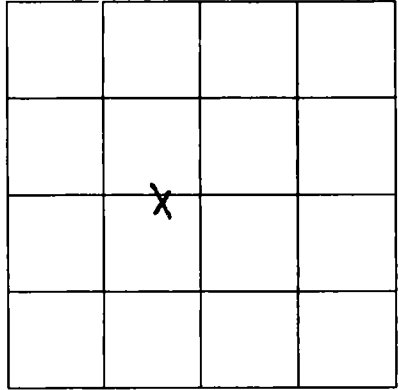

SECTION

19

Please indicate well location X.

ADDITIONAL INFORMATION

If more than one screen,
show location of each on sketch.