

**MISSISSIPPI DEPARTMENT OF ENVIRONMENTAL QUALITY**

Office of Land and Water Resources

P. O. Box 10631  
Jackson, MS 39289-0631

**WATER WELL DRILLERS LOG**

COUNTY WELL LOCATED  
**Jackson**

WELL NUMBER  
**K-2732**

CODED

DATE WELL COMPLETED  
**3-5-01**

PERMIT NUMBER

NAME OF DRILLING FIRM  
**Coast Water Well Service**

NAME & MAILING ADDRESS OF LANDOWNER  
**Bill Case**  
**Johns Bayou Circle**  
**Vandevue, Ms**

WELL LOCATION: SEC **25** TOWNSHIP **6 N** RANGE **7 W**

DISTANCE **3** MILES **SE** DIRECTION of **Vandevue** NEAREST TOWN

OTHER LANDMARK

WELL PURPOSE: Home, Irrigation, Municipal, Industrial, Fish Pond, etc.  
**Camp**

**PUMP DATA**

PUMP TYPE (Circle One):  
Submersible, Turbine, **Jet** Flowing Well, Other (Describe)

POWER TYPE (Circle One):  
**Electric**, Tractor, Diesel, Gasoline, Butane, Other (Describe) **H/P**

Pump Capacity (GPM) **9** No. of Stages **2** Setting Depth **1** FT.

PUMP TEST  
Well yielded \_\_\_\_\_ GPM with a drawdown of \_\_\_\_\_ ft. after \_\_\_\_\_ hours of pumping

**WELL DATA**

Well Depth **120'** Casing Diameter (In.) **2"** Casing Length (Ft.) **110'**

Type of Casing **pvc** Hole Depth **120'** Depth to Static Water Level **10'**

TYPE OF COMPLETION: (Circle One or More):  
**Natural Development**, Gravel Backed, Underreamed, Telescoped, Open Hole, Other

WELL GROUTED TO A DEPTH OF **10** FEET.  
Type Grout (circle one): Cement, **Bentonite** or Mix

**LOG DATA**

TYPE OF LOG RUN (Circle One):  
Electric, Gamma Ray, Density, Sonic, **No Log Run**, **Neutron**, Other (Describe)

Name of Organization Running Log

**SCREEN DATA**

Diameter - Inches **2"** Length - Feet **10'** Slot Size - Inches **.004**

Screen Type **pvc** Depth to Bottom Feet **120'**

**GEOLOGIC DATA (Office Use Only)**

Surface Elev.	Geologic Unit	Unit Thickness	Depth to Top
Subs. SWL	Date	Analysis	Aquifer Test

Driller's Remarks

Top of Lap Pipe or Reduction in Casing

**FEET** IF TELESKOPED OR MORE THAN ONE SCREEN: USE BACK PAGE

DESCRIPTION OF FORMATIONS ENCOUNTERED	FROM	TO
<b>TOP Soil</b>	<b>0</b>	<b>2</b>
<b>Orange Clay</b>	<b>2</b>	<b>17</b>
<b>White Coarse Sand</b>	<b>17</b>	<b>45</b>
<b>Orange clay</b>	<b>45</b>	<b>55</b>
<b>Medium + Coarse Sand</b>	<b>55</b>	<b>120</b>


FORMATIONS (Continued)	FROM	TO

**REC'D MAY 22 2001**

IF MORE SPACE IS NEEDED: USE BACK

If well telescopes please  
sketch and show depths.

GROUND LEVEL

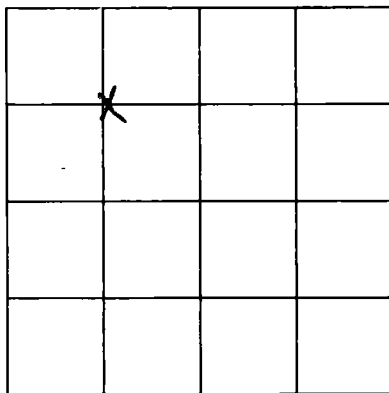

SECTION 25

Please indicate well location X.

ADDITIONAL INFORMATION

If more than one screen,  
show location of each on sketch.