

MISSISSIPPI DEPARTMENT OF ENVIRONMENTAL QUALITY
Office of Land and Water Resources

P. O. Box 10631
Jackson, MS 39289-0631
WATER WELL DRILLERS LOG

COUNTY WELL LOCATED
JACKSON

WELL NUMBER
R-2733

CODED

DATE WELL COMPLETED
3-30-01

PERMIT NUMBER

NAME OF DRILLING FIRM
Coastal Water Well Service

NAME & MAILING ADDRESS OF LANDOWNER
Tom Hinkle - New Age Develop.
Pinewood Hills Rd.
Vandeventer, Ms.

WELL LOCATION. SEC **9** TOWNSHIP **6 S** RANGE **7 E**

DISTANCE **2 1/2** Miles DIRECTION **SW** of **Vandeventer**

OTHER LANDMARK

WELL PURPOSE Home, Irrigation, Municipal, Industrial, Fish Pond, etc.

PUMP DATA

PUMP TYPE (Circle One):
Submersible, Turbine, Jet, Flowing Well,
Other (Describe) _____

POWER TYPE (Circle One):
 Electric, Tractor, Diesel, Gasoline, Butane,
Other (Describe) _____ H/P **1**

Pump Capacity (GPM) **8** No. of Stages **2** Setting Depth _____ FT.

PUMP TEST

Well yielded _____ GPM with
a drawdown of _____ ft.
after _____ hours of pumping

WELL DATA

Well Depth **215'** Casing Diameter (In.) **2"** Casing Length (Ft.) **205'**

Type of Casing **PVC** Hole Depth **215'** Depth to Static Water Level **35'**

LOG DATA

TYPE OF LOG RUN (Circle One):
Electric, Gamma Ray, Density, Sonic, Neutron,
Other (Describe) _____ No Log Run

Name of Organization Running Log

TYPE OF COMPLETION: (Circle One or More):
 Gravel Packed, Underreamed, Telescoped,
 Natural Development, Open Hole, Other

WELL GROUTED TO A DEPTH OF **10** FEET
Type Grout (circle one): Cement, Bentonite or Mix

GEOLOGIC DATA (Office Use Only)

Surface Elev.	Geologic Unit	Unit Thickness	Depth to Top
Subs. SWL	Date	Analysis	Aquifer Test

Driller's Remarks

Top of Lap Pipe or Reduction in Casing

FEET IF TELESCOPED OR MORE THAN ONE SCREEN: USE BACK PAGE

SCREEN DATA

Diameter - Inches **2"** Length - Feet **10'** Slot Size - Inches **.008**


Screen Type **PVC** Depth to Bottom - Feet **215'**

DESCRIPTION OF FORMATIONS ENCOUNTERED	FROM	TO
Top Soil	0	2
Orange Clay	2	16
White Coarse Sand	16	30
Orange + Blue Clay	30	72
Blue Clay	72	188
Medium + Coarse Sand	188	215

FORMATIONS (Continued)	FROM	TO
REC'D MAY 22 2001		

If well telescopes please
sketch and show depths.

GROUND LEVEL

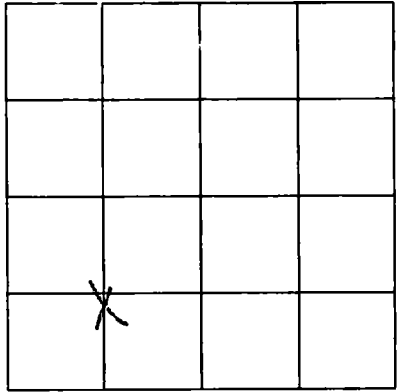

SECTION 9

Please indicate well location X.

ADDITIONAL INFORMATION

If more than one screen,
show location of each on sketch.