

**MISSISSIPPI DEPARTMENT OF ENVIRONMENTAL QUALITY**  
**Office of Land and Water Resources**

P. O. Box 10631  
 Jackson, MS 39289-0631  
**WATER WELL DRILLERS LOG**

COUNTY WELL LOCATED  
**Jackson**

WELL NUMBER CODED  
**H-2734**

DATE WELL COMPLETED  
**3-27-01**

PERMIT NUMBER

NAME OF DRILLING FIRM  
**Coast Water Well Service**

NAME & MAILING ADDRESS OF LANDOWNER  
**Ardis Nicholson**  
**Paige Bayou Rd.**  
**Vandeventer, Ms.**

WELL LOCATION: SEC TOWNSHIP RANGE  
**15 6 S 7 W**

DISTANCE DIRECTION NEAREST TOWN  
**1** Miles **East** of **Vandeventer**

OTHER LANDMARK

WELL PURPOSE:  Agric.  Irrigation, Municipal, Industrial, Fish Pond, etc.

**PUMP DATA**

PUMP TYPE (Circle One):  
 Submersible, Turbine,  Jet, Flowing Well,  
 Other (Describe) \_\_\_\_\_

POWER TYPE (Circle One):  
 Electric, Tractor, Diesel, Gasoline, Butane,  
 Other (Describe) \_\_\_\_\_ H/P \_\_\_\_\_

Pump Capacity (GPM) No. of Stages Setting Depth  
**8 2** FT.

PUMP TEST  
 Well yielded \_\_\_\_\_ GPM with  
 a drawdown of \_\_\_\_\_ ft.  
 after \_\_\_\_\_ hours of pumping

**WELL DATA**

Well Depth Casing Diameter (In.) Casing Length (Ft.)  
**126' 2" 116'**

Type of Casing Hole Depth Depth to Static Water Level  
**PVC 126' 35'**

**LOG DATA**

TYPE OF LOG RUN (Circle One):  
 Electric, Gamma Ray, Density, Sonic,  No Log Run, Neutron,  
 Other (Describe) \_\_\_\_\_

Name of Organization Running Log

TYPE OF COMPLETION: (Circle One or More):  
 Gravel Packed,  Underreamed,  Telescoped,  
 Natural Development,  Open Hole,  Other  
 (Describe) \_\_\_\_\_

**GEOLOGIC DATA (Office Use Only)**

Surface Elev.	Geologic Unit	Unit Thickness	Depth to Top
Subs. SWL	Date	Analysis	Aquifer Test

WELL GROUTED TO A DEPTH OF **10** FEET  
 Type Grout (circle one): Cement,  Bentonite, or Mix

Driller's Remarks

Top of Lap Pipe or Reduction in Casing

**FEET** IF TELESCOPED OR MORE THAN ONE SCREEN: USE BACK PAGE

**SCREEN DATA**

Diameter - Inches Length - Feet Slot Size - Inches  
**2" 10' .008**


Screen Type Depth to Bottom - Feet  
**PVC 126'**

DESCRIPTION OF FORMATIONS ENCOUNTERED	FROM	TO
Top Soil	0	2
Orange Clay	2	18
White Coarse Sand	18	36
Orange + White Clay	36	82
White Coarse Sand	82	126

FORMATIONS (Continued)	FROM	TO
<b>REC'D MAY 22 2001</b>		

If well telescopes please sketch and show depths.

GROUND LEVEL

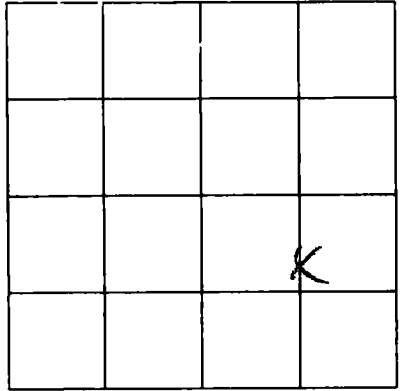

SECTION 15

Please indicate well location X.

ADDITIONAL INFORMATION

If more than one screen,  
show location of each on sketch.