

Coded

JACKSON

K 61

6-68

MISSISSIPPI
BOARD OF WATER COMMISSIONERS
416 North State Street
Jackson, Mississippi 39201

WATER WELL DRILLERS LOG

June 4 1968 L.L. Garland water wells Jackson
date well completed firm name county well located

LANDOWNER: Jr. Beaugis

description of formations encountered from to

Olan Springs, Miss
(mailing address)

WELL LOCATION:
sec. 24 T. 6 N. R. 1 E.
25 miles NE of O.S.
(distance) (direction) (nearest town)

WELL PURPOSE: home
(home, irrigation, municipal, industrial)

WELL COMPLETION DATA:
(1) diameter (inches) 2
(2) total depth (feet) 357
(3) static water level (feet) 18 below above
top of ground.

(4) casing _____ (material), _____ (depth),
_____ (size) if telescope see back.

(5) screen 10 _____ (length), _____ (depth to top)
2 _____ (size), brass (material)

(6) pump 1/2 _____ (HP), _____ (yield gpm)
electric (type power)

(7) electric log _____ (yes or no)
_____ (organization running log)

(8) how well bottom plugged W. Vabe


DRILLERS REMARKS: 27 ft

Sand

JUN - 4 1968
MISS. BOARD OF
WATER COMM.

If well telescopes please sketch and show depths.

GROUND LEVEL

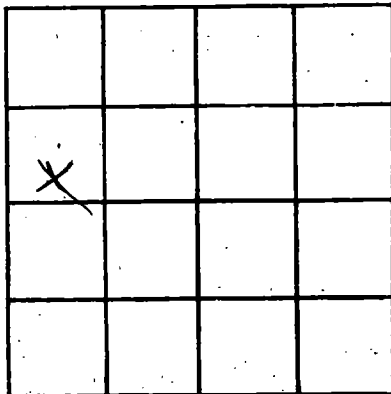

SECTION 24

Please indicate well location X.

ADDITIONAL INFORMATION

If more than one screen, show locations of each on sketch.