

JACKSON

cont locate

?

K


WATER WELL DRILLERS LOG

8-11-61

Date: 8-11, 1961, Driller: C. T. SWITZER WELL CO. County: Harrison

(Name)

	Description & Color of Materials Sand, Clay, Red Clay, Shell, etc.	Thick- ness Feet	Depth Feet
(1) Owner of Land: <u>A H Freeman</u> (Name) <u>Vance Leavy, Miss</u> (Address)	clay	0	23
(2) Location: <u>1/4</u> , <u>1/4</u> , Sec. <u>    </u> T <u>    </u> R <u>    </u> <u>    </u> miles of <u>    </u> (distance) (direction) (Nearest Town)	sand	23	43
(3) Topography: <u>X</u> (Hilly) (Flat) (Level)	clay	43	59
(4) Purpose of Well: <u>Domestic</u> (Domestic Irrigation Municipal, Industrial, Other)	sand	59	154
Information upon completion of well:	clay	154	306
(1) Diameter <u>4"</u> inches.	clay w/ sand streak	306	325
(2) Total Depth <u>1072</u> feet.	clay	325	346
(3) Water Level <u>36 +</u> feet below top of ground.	clay w/ sand streak	346	366
(4) Cased to <u>1072</u> , Size <u>4"</u>	sand	366	382
(5) Screen: Size <u>4"</u> , Length <u>40</u>	clay	382	386
(6) Were any formations sealed against pollution? <u>X</u> yes, <u>    </u> no.	clay w/ sand streak	386	406
If YES depth of formation	clay	406	451
Why <u>Health Dept Requirement</u>	sand	451	508
Drillers Remarks:	clay + shale	508	609
	clay	609	650
	clay w/ sand streak	650	691
	clay	691	712
	shale	712	752
	clay	752	772
	fine sand	772	799
	clay	799	825
	clay	825	853
	fellers earth	853	873
	clay	873	891
	rock	891	892
	clay	892	934
	fine sand	934	949
	clay	949	954
	shale + sand streak	954	994
	sand	994	1072

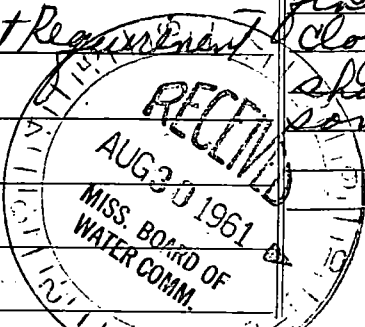

(Use Back Side)

Well No.

