

HANCOCK

MISSISSIPPI BOARD OF WATER COMMISSIONERS

K

WATER WELL DRILLERS LOG

K

3-3-65

Date: 3-3, 1965, Driller: Sutter Well Works County Hancock

(Name)

(1) Owner of Land: R. F. Patterson
 (Name)
1212 Josephine - New Orleans La
 (Address)

(2) Location: SE 1/4, SE 1/4, Sec. 12 T98R15W
6 miles W, of Bay St Louis
 (distance) (direction) (Nearest Town)

(3) Topography: flat
 (Hilly) (Flat) (Level)

(4) Purpose of Well: domestic
 (Domestic Irrigation
 Municipal, Industrial, Other)

Description & Color of Materials Sand, Clay, Red Clay, Shell, etc.	Thick- ness Feet	Depth Feet
Clay	10	10
sand	30	40
Clay	22	62
sand	12	74
Clay	11	85
sand	34	119

Information upon completion of well:

(1) Diameter 2 inches.

(2) Total Depth 119 feet.

(3) Water Level 11 feet below top of ground.

(4) Cased to all, Size 2"


(5) Screen: Size 2", Length 5'

(6) Were any formations sealed against pollution?
 yes, no.

If YES depth of formation _____

Why _____

Drillers Remarks: _____

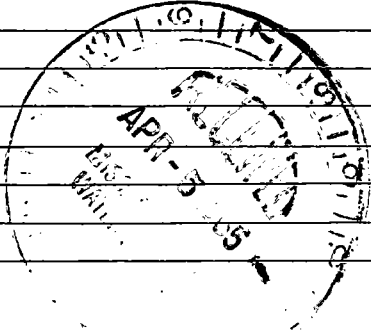

(Use Back Side)

Well No.

