

JACKSON MISSISSIPPI BOARD OF WATER COMMISSIONERS

L 27
9-30-60

WATER WELL DRILLERS LOG

Date: 9/30, 1960, Driller: Water Supply Co County JACKSON

3 4

(1) Owner of Land: J B Mathews
(Name)
Escatawpa Miss
(Address)

(2) Location: SE 1/4 NE 1/4, Sec 35 T6R14W
_____ miles _____ of _____
(distance) (direction) (Nearest Town)

(3) Topography: _____
(Hilly) (Flat) (Level)

(4) Purpose of Well: _____
 Domestic Irrigation
Municipal; Industrial; Other

Information upon completion of well:


- (1) Diameter 1 1/4 inches.
- (2) Total Depth 252 feet.
- (3) Water Level 5' feet below top of ground.
- (4) Cased to _____, Size _____.
- (5) Screen: Size 1 1/4, Length 10'.
- (6) Were any formations sealed against pollution?
_____ yes, _____ no.

If YES depth of formation _____
Why _____
Drillers Remarks: _____

Description & Color of Materials Sand, Clay, Red Clay, Shell, etc.		Thick- ness Feet	Depth Feet
0	Clay	21	Sand
78	Clay	84	Sand
147	Clay	231	Sand
252			

Depth Form Depth Form

Total Depth
252'

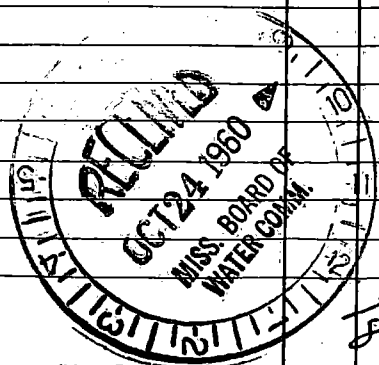

(Use Back Side)

