

JACKSON

MISSISSIPPI BOARD OF WATER COMMISSIONERS

~~2-3-65~~ L32

~~RENUMBER~~

12-31-65

WATER WELL DRILLERS LOG

Date: Dec. 31, 19 65, Driller: Carloss Well Supply County Shelby *Joehn*

(Name)

- (1) Owner of Land: Jackson Co. Bd. of Supervisors - (Name) Pascagoula (Jackson Co.), Mississippi
- (2) Location: ESCATAWPA AREA - Well # 4
 (Address)
1/4, 1/4, Sec. T R
_____ miles _____ of _____
 (distance) (direction) (Nearest Town)
- (3) Topography: Flat
 (Hilly) (Flat) (Level)
- (4) Purpose of Well: Municipal
 (Domestic Irrigation
 Municipal, Industrial, Other)

Description & Color of Materials Sand, Clay, Red Clay, Shell, etc.	Thick- ness Feet	Depth Feet
Top Soil	5	5'
Sand	10	15'
Soft Clay	50	65'
Sand	20	85'
Sand & Small Gravel	20	105'
Sand - Shell	30	135'
Hard Clay w/ Sandy Spts	20	155'
Clay Streaks	25	180'
Soft Clay and Sand	15	195'
Hard Clay	10	205'
Sandy Clay	8	213'
Sand Streaks	10	223'
Water Bearing Sand	22	245'
Clay	2	247'


Information upon completion of well:

- (1) Diameter 12 inches.
- (2) Total Depth 245' feet.
- (3) Water Level 12' feet below top of ground.
- (4) Cased to 220', Size 12"
- (5) Screen: Size 6", Length 22'
- (6) Were any formations sealed against pollution?
 Yes - Casing Cemented entire
 Length _____
 yes, _____ no.

If YES depth of formation _____

Why _____

Drillers Remarks: _____

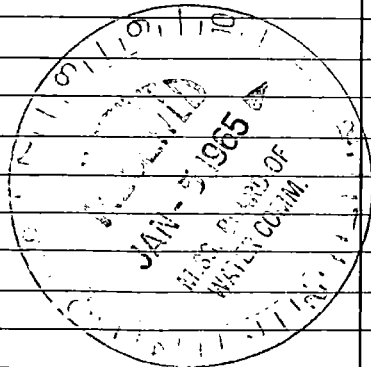

(Use Back Side)

Well No.

