

WATER WELL DRILLERS LOG

Colville

34  
8-12-60

Date: 8/17, 1960, Driller: Water Supply Co. Jackson County

(1) Owner of Land: GLENN D YAWN  
(Name)  
Escatawpa Miss  
(Address)

(2) Location: NE 1/4, SE 1/4, Sec. 24 T5S R5E  
5 miles North, of Escatawpa  
(distance) (direction) (Nearest Town)

(3) Topography:  (Hilly)  (Flat)  (Level)

(4) Purpose of Well: Domestic  
(Domestic Irrigation, Municipal, Industrial, Other)

Information upon completion of well:


- (1) Diameter 1 1/4 inches.
- (2) Total Depth 357 feet.
- (3) Water Level + 1.6 flows feet below top of ground.
- (4) Cased to None, Size \_\_\_\_\_
- (5) Screen: Size 1 1/4, Length 10'
- (6) Were any formations sealed against pollution?  
\_\_\_\_\_ yes, \_\_\_\_\_ no.

If YES depth of formation \_\_\_\_\_  
Why \_\_\_\_\_

Drillers Remarks:  
This well flows approx 2 gal per min.

Description & Color of Materials Sand, Clay, Red Clay, Shell, etc.	Thick- ness Feet	Depth Feet
6 Clay Red	10	6
21 Sand + gravel	42	21
63 Sand + "	146	63
226 Fine Sand	231	226
242 Sand	249	242
310 STREAKS	320	310
357		357

TD 357

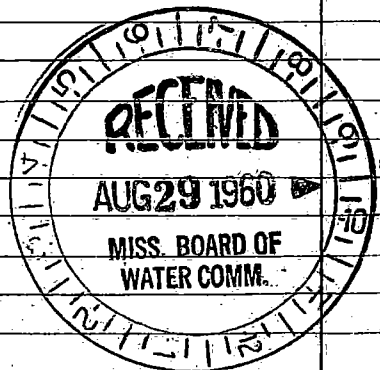

(Use Back Side)

Well No. 8

