

JACKSON MISSISSIPPI BOARD OF WATER COMMISSIONERS

L 36  
7-9-61

WATER WELL DRILLERS LOG

COLVILLE

Date: July 9, 1961, Driller: Water Supply Co County JACKSON  
49 (Name)

(1) Owner of Land: Lewis YAWN  
(Name)  
Porters Sub Division  
(Address)

(2) Location: NE 1/4, NW 1/4, Sec. 23 T6SR6W  
7 miles North of Escatawpa  
(distance) (direction) (Nearest Town)

(3) Topography:  (Hilly)  (Flat)  (Level)

(4) Purpose of Well:  Domestic Irrigation  
 Municipal, Industrial, Other

Description & Color of Materials Sand, Clay, Red Clay, Shell, etc.	Thick- ness Feet	Depth Feet
0 CLAY	63	SAND
135 CLAY	210	SAND
241 IR.		

Information upon completion of well:

(1) Diameter 1 1/4 inches.

(2) Total Depth 241 feet.

(3) Water Level 4 feet below top of ground.

(4) Cased to \_\_\_\_\_, Size \_\_\_\_\_


(5) Screen: Size 1 1/4, Length 10'

(6) Were any formations sealed against pollution?  
\_\_\_\_\_ yes, \_\_\_\_\_ no.

If YES depth of formation \_\_\_\_\_

Why \_\_\_\_\_

Drillers Remarks: \_\_\_\_\_

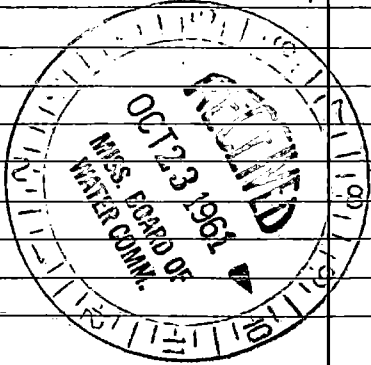

Well No. 59

(Use Back Side)

