

JACKSON MISSISSIPPI BOARD OF WATER COMMISSIONERS

L 37

8-28-61

WATER WELL DRILLERS LOG

Colville


L

Date: 8/28, 1961, Driller: Water Supply Co. County JACKSON

49

(Name)

	Description & Color of Materials Sand, Clay, Red Clay, Shell, etc.	Thick- ness Feet	Depth Feet
(1) Owner of Land: <u>A. O. DUMAS</u> (Name) <u>Three Rivers</u> (Address)			
(2) Location: <u>SE 1/4 SE 1/4, Sec. 43 T6SR6W</u> <u>8 miles North</u> , of <u>Mass Point</u> (distance) (direction) (Nearest Town)			
(3) Topography: <input checked="" type="checkbox"/> (Hilly) <input type="checkbox"/> (Flat) <input type="checkbox"/> (Level)			
(4) Purpose of Well: <input type="checkbox"/> (Domestic Irrigation) <input checked="" type="checkbox"/> (Municipal, Industrial) <input type="checkbox"/> (Other)			
Information upon completion of well:			
(1) Diameter <u>2</u> inches.			
(2) Total Depth <u>231</u> feet.			
(3) Water Level <u>6'</u> feet below top of ground.			
(4) Cased to _____, Size _____			
(5) Screen: Size <u>2</u> , Length <u>10</u>			
(6) Were any formations sealed against pollution? _____ yes, _____ no <input checked="" type="checkbox"/>			
If YES depth of formation _____			
Why _____			
Drillers Remarks: _____ _____ _____	<p><i>Depth Form depth Form</i></p> <p><i>0 Red Clay 21 Streaky</i></p> <p><i>42 Gravel 105 Streaky</i></p> <p><i>136 CLAY 210 SAND</i></p> <p><i>231 JAW</i></p> <p><i>W L 6'</i></p>		

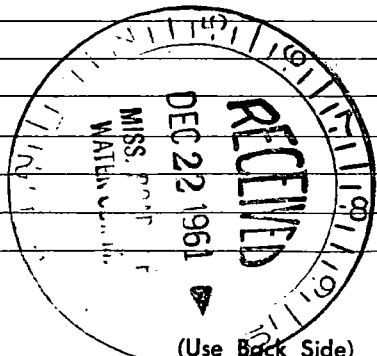

Well No. 110

