

JACKSON MISSISSIPPI BOARD OF WATER COMMISSIONERS

L 38


9-5-61

WATER WELL DRILLERS LOG

COLVILLE

Date: 9/5, 1961, Driller: Water Supply Co County JACKSON  
 49 (Name)

(1) Owner of Land	Description & Color of Materials Sand, Clay, Red Clay, Shell, etc.	Thick- ness Feet	Depth Feet
Mrs Edna THORNTON (Name) Three RIVERS (Address)			
(2) Location NE 1/4 NW 1/4, Sec. 23 T6SR6W 10 miles North of Moss Point (distance) (direction) (Nearest Town)			
(3) Topography: (Hilly) (Flat) (Level) <input checked="" type="checkbox"/>	Depth Form depth Form.		
(4) Purpose of Well: <input checked="" type="checkbox"/> Domestic Irrigation Municipal, Industrial, Other)	0 Red clay 21 Blue Clay		
	53 Sand Gravel 130 Clay		
	180 Fine sand 188 Clay		
	216 Sand 234 IR		
Information upon completion of well:			
(1) Diameter 1 1/4 inches.			
(2) Total Depth 234 feet.			
(3) Water Level 6 feet below top of ground.			
(4) Cased to _____, Size _____			
(5) Screen: Size 1 1/4, Length 10			
(6) Were any formations sealed against pollution?			
_____ yes, _____ no. <input checked="" type="checkbox"/>			
If YES depth of formation _____			
Why _____			
Drillers Remarks: _____			

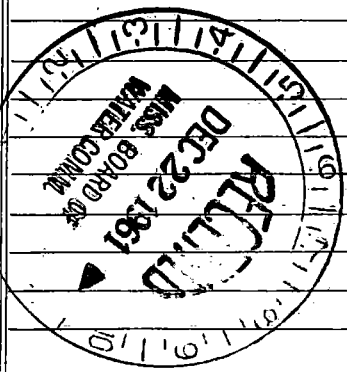

Well No. 41

(Use Back Side)

