

JACKSON

MISSISSIPPI BOARD OF WATER COMMISSIONERS

L 39

WATER WELL DRILLERS LOG

9-26-61

Date: Sept 26, 1961, Driller: Colville

County Jackson

49

(Name)

(1) Owner of Land: Dewey Broadus

(Name)

Escatawpa

(Address)

(2) Location: SE 1/4, NW 1/4, Sec. 26 T6S R16W

1/2 miles North of Escatawpa

(Distance)

(Direction)

(Nearest Town)

(3) Topography: Flat

(Hilly)

(Flat)

(Level)

(4) Purpose of Well: Domestic

(Domestic Irrigation
Municipal, Industrial, Other)

Description & Color of Materials
Sand, Clay, Red Clay, Shell, etc.

Thick-
ness
Feet

Depth
Feet

SAND

21

GRAVEL

42 63

SAND

69 132

CLAY

74 206

SAND

15 221

TD

Information upon completion of well:

(1) Diameter 1 1/4 inches.

(2) Total Depth 221 feet.

(3) Water Level 6' 10" feet below top of ground.

(4) Cased to _____, Size _____

(5) Screen: Size 1 1/4, Length 10'


(6) Were any formations sealed against pollution?

yes, no.

If YES depth of formation _____

Why _____

Drillers Remarks: _____

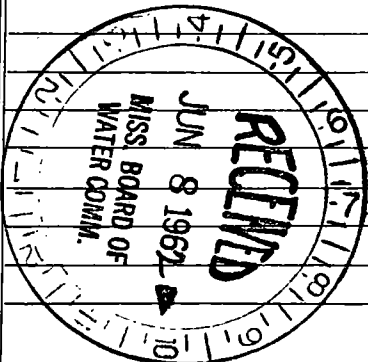

(Use Back Side)

Well No. 49

