

L 42

4-27-62

WATER WELL DRILLERS LOG

Date: 4/27, 1962, Driller: Polville County Jackson

40

(Name)

(1) Owner of Land: J.D. Ferguson (Name) Escatawpa (Address)

(2) Location: SW 1/4, SE 1/4, Sec 35 T5R6E20 (distance) (direction) (Nearest Town)

(3) Topography: (Hilly) (Flat) (Level)

(4) Purpose of Well: (Domestic Irrigation) (Municipal, Industrial, Other)

Table with 3 columns: Description & Color of Materials, Thickness Feet, Depth Feet. Rows include: 0 Clay, 42 Gravel, 84 Clay, 105 Sandy clay, 126 Sand, 160 Clay, 348 Sand, 362 Clay, 425 Sand, 435 Clay, 452 Sand, 460 Clay, 462 Sand, 480 Clay, 504 Sand, 515 Clay, 630 Sand, 651

Information upon completion of well:

(1) Diameter: 2 inches.

(2) Total Depth: 651 feet.

(3) Water Level: + 6-6" above ground.

(4) Cased to: Size


(5) Screen: Size 2", Length 10

(6) Were any formations sealed against pollution? yes, no.

If YES depth of formation

Why

Drillers Remarks:

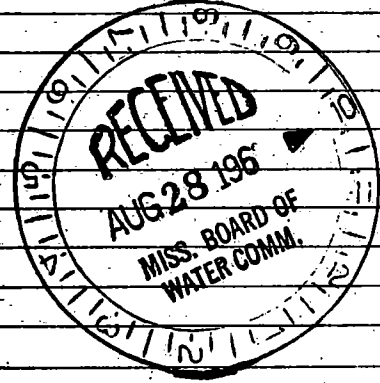

(Use Back Side)

Well No. 119

Handwritten notes at the top of the page, including a large circled 'D' and other illegible scribbles.

A large table with multiple columns and rows, containing handwritten entries. The text is extremely faint and difficult to decipher, but appears to be organized into a structured grid.