

JACKSON MISSISSIPPI BOARD OF WATER COMMISSIONERS

L 44
6-8-62

WATER WELL DRILLERS LOG

Date: 6-8, 1962, Driller: Colville County Jackson
49 (Name)

(1) Owner of Land:	Description & Color of Materials Sand, Clay, Red Clay, Shell, etc.	Thick- ness Feet	Depth Feet
<u>A. D. Morrison</u> (Name) <u>Helena Miss.</u> (Address)	<u>Sandy Clay</u>	<u>30</u>	<u>30</u>
(2) Location: <u>NW 1/4, NW 1/4, Sec. 25 T6S R6W</u>	<u>Clay</u>	<u>59</u>	<u>89</u>
<u>5</u> miles <u>NORTH</u> of <u>Escatawpa</u> (distance) (direction) (Nearest Town)	<u>Gravel</u>	<u>11</u>	<u>100</u>
(3) Topography: <u>FLAT</u> (Hilly) (Flat) (Level)	<u>Clay</u>	<u>31</u>	<u>131</u>
(4) Purpose of Well: <u>DOMESTIC</u> (Domestic Irrigation Municipal, Industrial, Other)	<u>SAND</u>	<u>10</u>	<u>141</u>


Information upon completion of well:

- (1) Diameter 1 1/2 inches.
- (2) Total Depth 141 feet.
- (3) Water Level 12 feet below top of ground.
- (4) Cased to _____, Size _____.
- (5) Screen: Size 80 gr., Length 10.
- (6) Were any formations sealed against pollution?
_____ yes, _____ no.

If YES depth of formation _____

Why _____

Drillers Remarks: _____

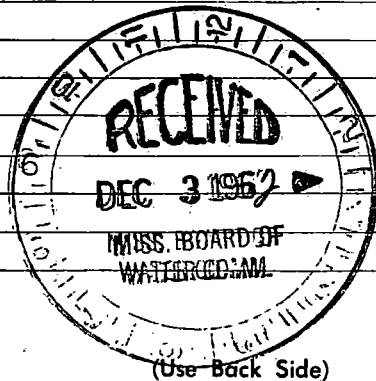

Well No. 140

