

JACKSON

L 45


WATER WELL DRILLERS LOG

7-4-62

Date: July 4, 1962 Driller: Flim Colville County Jackson

(Name)

(1) Owner of Land:	Description & Color of Materials Sand; Clay, Red Clay, Shell, etc.	Thick- ness Feet	Depth Feet
(Name) <u>Escatawpa</u>	0-12 clay		
(Address) <u>Miss</u>	12-21 sand		
(2) Location: <u>NE 1/4, SW 1/4, Sec. 26 T5R6E</u>	21-42 sand		
<u>4</u> miles <u>North</u> , of <u>Escatawpa</u>	42-63 Sand & Gravel		
(distance) (direction) (Nearest Town)	63-84 Gravel		
(3) Topography: <u>flat</u>	84-105 Gravel		
(Hilly) (Flat) (Level)	105-120 Gravel		
(4) Purpose of Well: <u>Domestic</u>	120-126 Strakes		
(Domestic Irrigation Municipal, Industrial, Other)	126-147 Strakes		
Information upon completion of well:	147-168 clay		
(1) Diameter: <u>1 1/4</u> inches.	168-189 clay		
(2) Total Depth: <u>370</u> feet.	189-208 Dirty Clay		
(3) Water Level: <u>+ 6'</u> feet below top of ground.	208-210 sand		
(4) Cased to _____, Size _____	210-231 Strakes		
(5) Screen: Size <u>1 1/4</u> , Length <u>10'</u>	231-235 Sand		
(6) Were any formations sealed against pollution?	235-252 clay		
_____ yes, <u>X</u> no.	252-276 clay		
If YES depth of formation _____	276-297 Dirty clay		
Why _____	297-318 clay		
Drillers Remarks: _____	318-337 Dirty clay		
_____	337-339 Sand		
_____	339-360 Sand		
_____	360-370 Sand		

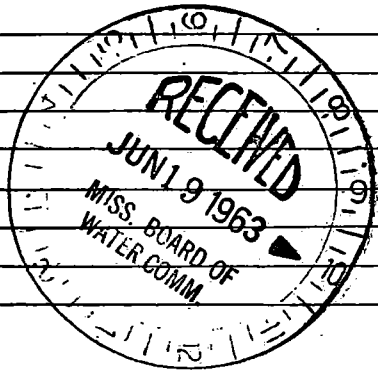

(Use Back Side)

Well No. 159

