

# JACKSON MISSISSIPPI BOARD OF WATER COMMISSIONERS

L 46  
7-26-62

## WATER WELL DRILLERS LOG

Date: 7-26, 1962, Driller: George Colville County Jackson  
49 (Name)


(1) Owner of Land: <u>T. E. TENNER</u> <small>(Name)</small>	Description & Color of Materials Sand, Clay, Red Clay, Shell, etc.	Thick- ness Feet	Depth Feet
<u>Wade Miss.</u>	<u>Clay</u>	<u>42</u>	<u>42</u>
<u>SE 1/4, SE 1/4, Sec. 11 T6S R6W</u>	<u>SAND</u>	<u>42</u>	<u>84</u>
<u>7</u> miles <u>South</u> of <u>Wade</u> <small>(distance) (direction) (Nearest Town)</small>	<u>CLAY</u>	<u>16</u>	<u>100</u>
<u>Level</u> <small>(Hilly) (Flat) (Level)</small>	<u>SAND</u>	<u>47</u>	<u>147</u>
<u>Domestic</u> <small>(Domestic Irrigation Municipal, Industrial, Other)</small>	<u>Clay</u>	<u>73</u>	<u>220</u>
	<u>SAND</u>	<u>50</u>	<u>278</u>

Information upon completion of well:

- (1) Diameter 2 inches.
- (2) Total Depth 278 feet.
- (3) Water Level 2 feet below top of ground.
- (4) Cased to \_\_\_\_\_, Size \_\_\_\_\_.
- (5) Screen: Size No. 940 Length 5.
- (6) Were any formations sealed against pollution?  
\_\_\_\_\_ yes,  no.

If YES depth of formation \_\_\_\_\_  
Why \_\_\_\_\_

Drillers Remarks: \_\_\_\_\_  
\_\_\_\_\_  
\_\_\_\_\_

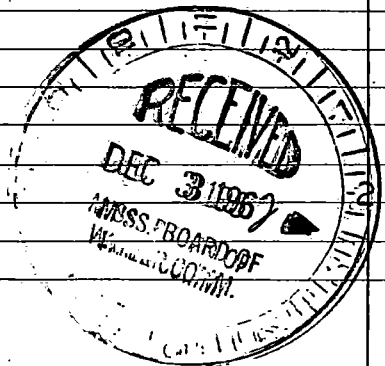

(Use Back Side)

Well No. 149

