

# JACKSON MISSISSIPPI BOARD OF WATER COMMISSIONERS

L 47  
7-30-62

## WATER WELL DRILLERS LOG

Date: 7-30, 1962, Driller: George Colville County Jackson  
49 (Name)

(1) Owner of Land: <u>D. E. Westbrook</u> (Name)	Description & Color of Materials Sand, Clay, Red Clay, Shell, etc.	Thick- ness Feet	Depth Feet
<u>Escatawpa, Miss</u> (Address)	<u>CLAY</u>	<u>12</u>	<u>12</u>
(2) Location: <u>NW 1/4, NE 1/4, Sec. 26 T63R6W</u> <u>3</u> miles <u>NORTH</u> of <u>Escatawpa</u> (distance) (direction) (Nearest Town)	<u>SAND</u>	<u>57</u>	<u>63</u>
	<u>GRAVEL</u>	<u>52</u>	<u>115</u>
	<u>CLAY</u>	<u>32</u>	<u>147</u>
	<u>SAND</u>	<u>20</u>	<u>167</u>
(3) Topography: <u>FLAT</u> (Hilly) (Flat) (Level)	<u>CLAY</u>	<u>87</u>	<u>254</u>
(4) Purpose of Well: _____ (Domestic Irrigation Municipal, Industrial, Other)	<u>SAND</u>	<u>4</u>	<u>258</u>
	<u>CLAY</u>	<u>95</u>	<u>353</u>
	<u>SAND</u>	<u>20</u>	<u>373</u>


Information upon completion of well:

- (1) Diameter 1 1/4 inches.
- (2) Total Depth 370 feet.
- (3) Water Level 4 feet above below top of ground.
- (4) Cased to \_\_\_\_\_, Size \_\_\_\_\_.
- (5) Screen: Size 80 mesh, Length 10'.
- (6) Were any formations sealed against pollution?  
\_\_\_\_\_ yes,  no.

If YES depth of formation \_\_\_\_\_

Why \_\_\_\_\_

Drillers Remarks: \_\_\_\_\_

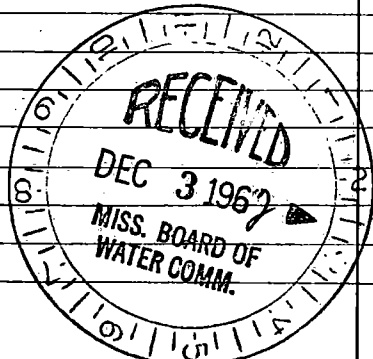

(Use Back Side)

Well No. 49

