

L 48

WATER WELL DRILLERS LOG

11-28-62

Date Nov 28, 1962, Driller: George Cobille County Jackson

49

(Name)

(1) Owner of Land: F. D. Robertson
(Name)

Description & Color of Materials
Sand, Clay, Red Clay, Shell, etc.

Thick-
ness
Feet

Depth
Feet

Osceola Miss
(Address)

0-17 yellow clay

17-62 sand

62-105 clay

105-157 sand
T.P.

(2) Location SW 1/4 SW 1/4, Sec. 36 T65R6W

3 miles North, of Osceola
(distance) (direction) (Nearest Town)

(3) Topography: flat
(Hilly) (Flat) (Level)

(4) Purpose of Well: Domestic
(Domestic Irrigation
Municipal, Industrial, Other)

Information upon completion of well:

(1) Diameter 1 1/4 inches.

(2) Total Depth 157 feet.

(3) Water Level 7' feet below top of ground.

(4) Cased to _____, Size _____

(5) Screen: Size 1 1/4, Length 5'


(6) Were any formations sealed against pollution?

_____ yes, X no.

If YES depth of formation _____

Why _____

Drillers Remarks: _____

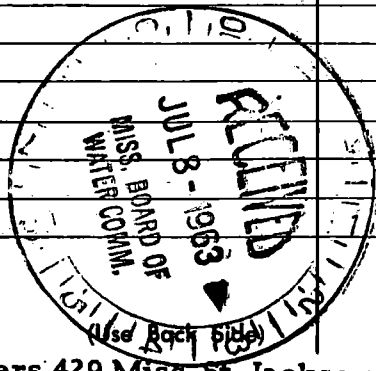

Well No.
74
194

