

JACKSON

L 49

1-9-63

WATER WELL DRILLERS LOG

Date: Jan 9, 1963, Driller: Andrew Cobille County Jackson
 49 (Name)

	Description & Color of Materials Sand, Clay, Red Clay, Shell, etc.	Thick- ness Feet	Depth Feet
(1) Owner of Land: <u>Joxie Bourn</u> (Name) <u>Wolf Ridge</u> (Address)	0-42 streaks		
(2) Location: <u>SW 1/4, NE 1/4, Sec. 1 T12R1W</u> <u>7</u> miles <u>south</u> , of <u>Wade</u> (distance) (direction) (Nearest Town)	42-52 clay 52-123 sand & gravel 123-147 clay 147-199 gritty clay 199-241 clay 241-262 sand		
(3) Topography: _____ (Hilly) (Flat) (Level)	T.D.		
(4) Purpose of Well: _____ (Domestic Irrigation Municipal, Industrial, Other)			

Information upon completion of well:

(1) Diameter 1 1/4 inches.

(2) Total Depth 262 feet.

(3) Water Level 11'6" feet below top of ground.

(4) Cased to _____, Size _____


(5) Screen: Size 1 1/4, Length 10'

(6) Were any formations sealed against pollution?
 _____ yes, no.

If YES depth of formation _____

Why _____

Drillers Remarks: _____

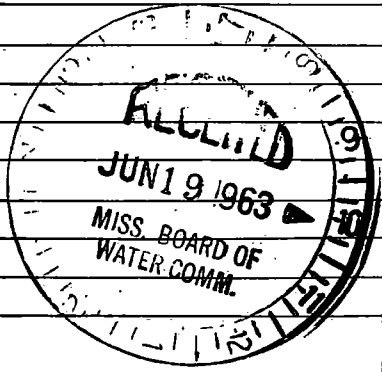

Well No.
145

(Use Back Side)

