

**MISSISSIPPI  
BOARD OF WATER COMMISSIONERS**  
416 North State Street  
Jackson, Mississippi 39201

**WATER WELL DRILLERS LOG**

Oct 15 1963 Colville Water Supply Jackson  
 date well completed firm name county well located

LANDOWNER: A.C.

description of formations encountered from to

Franklin  
Escatawpa  
(mailing address)

Clay	0	30
Sand	30	75
Clay	75	164
Sand	164	220

WELL LOCATION:  
 sec 35 T 6 N R 6 E  
7 miles north of Maple Point  
 (distance) (direction) (nearest town)

WELL PURPOSE: Home  
 (home, irrigation, municipal, industrial)

WELL COMPLETION DATA:  
 (1) diameter (inches) 1 1/4  
 (2) total depth (feet) 220  
 (3) static water-level (feet) 7 below above top of ground.  
 (4) casing (material) (depth)  
 (size) If telescope see back.  
 (5) screen 51 215  
 (length) (depth to top)  
1 1/4 Stainless  
 (size) (material)

(6) pump (HP) (yield gpm)  
 (type power)  
 (7) electric log no  
 (yes or no)  
 (organization running log)

(8) how well bottom plugged BP Nabe


DRILLERS REMARKS:



If well telescopes please sketch and show depths.

GROUND LEVEL

NW SE

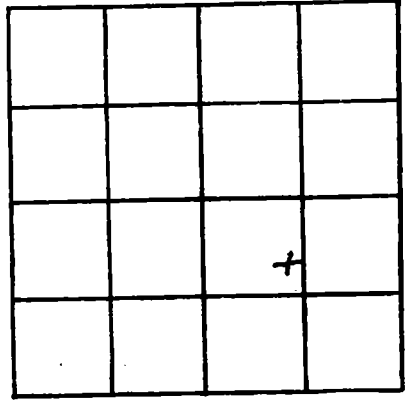

SECTION 35

Please indicate well location X.

ADDITIONAL INFORMATION

If more than one screen,  
show locations of each on sketch.