

4 4

Jackson
L 52
11-63

MISSISSIPPI
BOARD OF WATER COMMISSIONERS
416 North State Street
Jackson, Mississippi 39201

WATER WELL DRILLERS LOG

Nov 16 1963 Calville Water Supply Jackson
date well completed firm name county well located

LANDOWNER: C. W. Sherman

description of formations encountered	from to	
Clay	0	16
Sand	16	130
Clay	130	217
Sand	217	241

Geokopa Mine,
(mailing address)

WELL LOCATION:
sec. 26 T. 6 N R. 6 E
5 miles north of Meridian
(distance) (direction) (nearest town)

WELL PURPOSE: Home
(home, irrigation, municipal, industrial)

WELL COMPLETION DATA:

- (1) diameter (inches) 1 1/4
- (2) total depth (feet) 241
- (3) static water level (feet) 8 1/2 below above top of ground.
- (4) casing (material) _____ (depth) _____
(size) _____ if telescope see back.
- (5) screen 5 236
(length) (depth to top)
1 1/4 brass
(size) (material)
- (6) pump _____ (HP) _____ (yield gpm)
(type power) _____
- (7) electric log no
(yes or no)
(organization running log) _____
- (8) how well bottom plugged BP


DRILLERS REMARKS:



If well telescopes please sketch and show depths.

SE NW

GROUND LEVEL

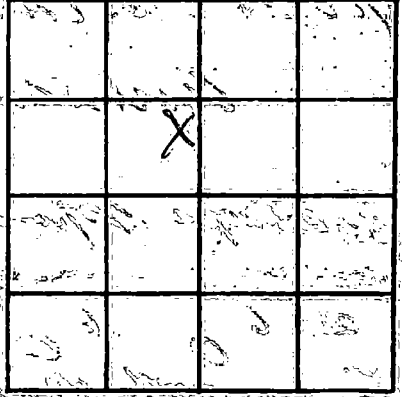

SECTION 26

Please indicate well location X.

ADDITIONAL INFORMATION

If more than one screen, show locations of each on sketch.