

49

MISSISSIPPI
 BOARD OF WATER COMMISSIONERS
 416 North State Street
 Jackson, Mississippi 39201

WATER WELL DRILLERS LOG

Jackson
 L 53
 3-64

May 25 1964 Colville Water Supply Jackson
 date well completed firm name county well located

LANDOWNER: Barton
Homes
Principals Man
 (mailing address)

description of formations encountered	from to	
	ft	ft
yellow clay	0	20
blue clay	20	24
sand	24	140
clay	140	231
sand	231	252

WELL LOCATION:
 sec. 36 T. 6 N. R. 6 E.
5 miles north of Miss Point
 (distance) (direction) (nearest town)

WELL PURPOSE: Home
 (home, irrigation, municipal, industrial)

WELL COMPLETION DATA:

- (1) diameter (Inches) 1 1/4
- (2) total depth (feet) 252
- (3) static water level (feet) 5 ^{below} _{above} top of ground.
- (4) casing galv (material), (depth) _____
 _____ if telescope see back.
 (size)
- (5) screen 5 (length), 247 (depth to top)
1 1/4 (size), brass (material)
- (6) pump _____ (HP) _____ (yield gpm)
 _____ (type power)
- (7) electric log no (yes or no)
 _____ (organization running log)
- (8) how well bottom plugged BP Valve


DRILLERS REMARKS:



If well telescopes please sketch and show depths:

GROUND LEVEL

SW NE

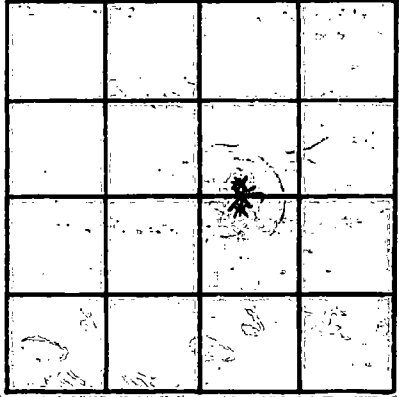

SECTION 35

Please indicate well location X.

ADDITIONAL INFORMATION

If more than one screen, show locations of each on sketch.