

Jackson
L 54
1-66

MISSISSIPPI BOARD OF WATER COMMISSIONERS

WATER WELL DRILLERS LOG

Date: Jan 24, 1966, Driller: George Colville (Colville) ~~W. Stark~~ (Water Supply) County Jackson
49 (Name)

(1) Owner of Land: TOM L. DeLashment
(Name)
Escatawpa
(Address)

(2) Location: NW 1/4, NW 1/4, Sec. 35 T5 R 6 W
3 miles N of Escatawpa
(distance) (direction) (Nearest Town)

(3) Topography: Level
(Hilly) (Flat) (Level)

(4) Purpose of Well: Dom
(Domestic Irrigation
Municipal, Industrial, Other)

Description & Color of Materials Sand, Clay, Red Clay, Shell, etc.	Thick- ness Feet	Depth Feet
CLAY	22	22
SAND	44	66
SAND & CLAY streaks	22	88
SAND	14	102
CLAY	4	106
SAND	154	160
CLAY	180	340
SAND	12	352
TD		

Information upon completion of well:

(1) Diameter 1 1/4 inches.

(2) Total Depth 352 feet.

(3) Water Level 46 feet Above below top of ground.

(4) Cased to 347, Size 1 1/4.


(5) Screen: Size 1/4" x .008, Length 5.

(6) Were there any formations sealed against pollution?
 yes, no.

If YES depth of formation _____

Why _____

Drillers Remarks: _____

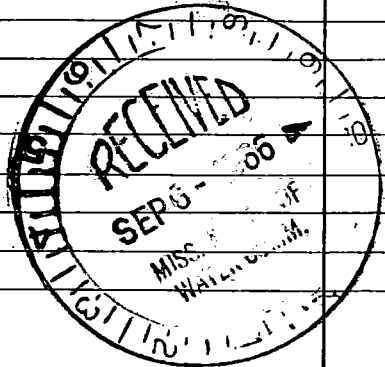

(Use Back Side)

Well No. _____

