

Jackson
L 55
1-28-66

MISSISSIPPI BOARD OF WATER COMMISSIONERS

WATER WELL DRILLERS LOG

Date: Jan 28, 1966, Driller: George Colville (Name) Water Supply County Jackson
49

(1) Owner of Land: J. D. Kelly
(Name)
Escatawpa, Miss.
(Address)

(2) Location: NW 1/4, NW 1/4, Sec 35 T6S R6W
3 miles N of Escatawpa
(distance) (direction) (Nearest Town)

(3) Topography: Level
(Hilly) (Flat) (Level)

(4) Purpose of Well: DOM.
(Domestic Irrigation
Municipal, Industrial, Other)

Description & Color of Materials Sand, Clay, Red Clay, Shell, etc.	Thick- ness Feet	Depth Feet
<u>CLAY</u>	<u>14</u>	<u>14</u>
<u>SAND</u>	<u>8</u>	<u>22</u>
<u>GRAVEL</u>	<u>44</u>	<u>66</u>
<u>SAND</u>	<u>94</u>	<u>160</u>
<u>CLAY</u>	<u>175</u>	<u>335</u>
<u>SAND</u>	<u>22</u>	<u>357</u>

Information upon completion of well:

(1) Diameter 1 1/4 inches.

(2) Total Depth 357 feet.

(3) Water Level +6 feet above ~~below~~ top of ground.

(4) Cased to 352, Size 1 1/4


(5) Screen: Size 1 1/4 x .008, Length 5 ft.

(6) Were any formations sealed against pollution?
 yes, no.

If YES depth of formation _____

Why _____

Drillers Remarks: _____

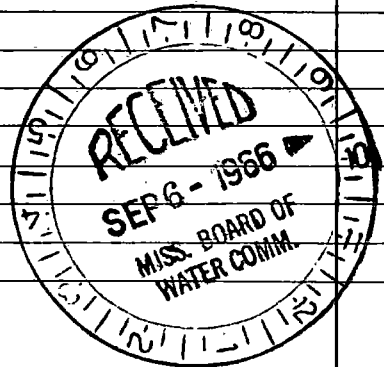

(Use Back Side)

Well No.

