

JACKSON MISSISSIPPI BOARD OF WATER COMMISSIONERS

L 56

4-22-66

WATER WELL DRILLERS LOG

Date: APR. 22, 1966, Driller: George Colville County Jackson

49

(Name)

(1) Owner of Land: James D. Crowe

(Name)

Box 179 Pascagoula Miss

(Address)

(2) Location: NW 1/4, SW 1/4, Sec. 36 T6 R6 W

3 1/2 miles NORTH of Escatawpa

(distance)

(direction)

(Nearest Town)

(3) Topography: Level

(Hilly)

(Flat)

(Level)

(4) Purpose of Well: Domestic

(Domestic Irrigation
Municipal, Industrial, Other)

Description & Color of Materials
Sand, Clay, Red Clay, Shell, etc.

Thick-
ness
Feet

Depth
Feet

Yellow Clay

14 14

Sand

46 60

Clay

1 61

Gravel

43 104

Wood

1 105

Blue Clay

129 234

Sand

11 245

Information upon completion of well:

(1) Diameter 1 1/4 inches.

(2) Total Depth 245 feet.

(3) Water Level 8' feet below top of ground.

(4) Cased to 235, Size 1 1/4

(5) Screen: Size 80gr, Length 10 ft.


(6) Were any formations sealed against pollution?

no

If YES depth of formation _____

Why _____

Drillers Remarks: _____

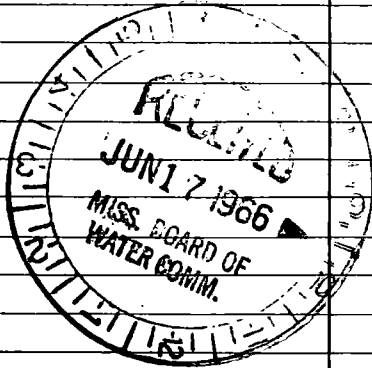

(Use Back Side)

Well No. 49

