

49

JACKSON
L 57
8-67

MISSISSIPPI
BOARD OF WATER COMMISSIONERS
416 North State Street
Jackson, Mississippi 39201

WATER WELL DRILLERS LOG


Aug. 9 1967 Coast Water Well Service Jackson
date well completed firm name county well located

LANDOWNER: Donald Wilson
P.O. B. 163
Moss Point, Miss.
(mailing address)
WELL LOCATION:
sec. 36 T. 6 N. R. 6 E.
3 miles North of Eastman
(distance) (direction) (nearest town)

description of formations encountered	from	to
Blue clay	0	70
Coarse sand	70	100
Blue clay	100	130
Fine blue sand	130	149
Blue clay	149	349
Sandy shale	349	374
Blue clay & shale shell	374	458
Medium sand	458	496

WELL PURPOSE: Home
(home, irrigation, municipal, industrial)

WELL COMPLETION DATA:
(1) diameter (inches) Two in.
(2) total depth (feet) 496
(3) static water level (feet) 8 below top of ground.
(4) casing Galv. 491
(material) (depth)
2 in. If telescope see back.
(size)
(5) screen 5 ft. 491
(length) (depth to top)
10 slot Stainless Steel
(size) (material)
(6) pump 1/2 12
(HP) (yield gpm)
Elect.
(type power)
(7) electric log no
(yes or no)
N. A.
(organization running log)
(8) how well bottom plugged
Backwash valve

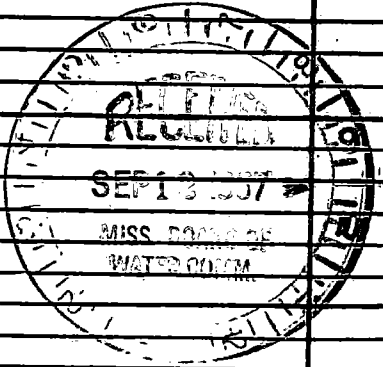

DRILLERS REMARKS:

If well telescopes please sketch and show depths.

GROUND LEVEL

X

SECTION 36

Please indicate well location X.

ADDITIONAL INFORMATION

If more than one screen, show locations of each on sketch.