

49

dots

Jackson
L 59
9-63

MISSISSIPPI
 BOARD OF WATER COMMISSIONERS
 416 North State Street
 Jackson, Mississippi 39201

WATER WELL DRILLERS LOG

Sept 11 1963 Cabille Water Supply Jackson
 date well completed firm name county well located

LANDOWNER: P. J. Johnson

description of formations encountered	depth	
	from	to
<u>Clay</u>	<u>0</u>	<u>24</u>
<u>Sand</u>	<u>24</u>	<u>147</u>
<u>Clay</u>	<u>147</u>	<u>231</u>
<u>Sand</u>	<u>231</u>	<u>250</u>

Monticello Miss
(mailing address)

WELL LOCATION:
 sec. 35 T 6 N R 6 E
5 miles North of Boe
 (distance) (direction) (nearest town)

WELL PURPOSE: Home
(home, irrigation, municipal, industrial)

- WELL COMPLETION DATA:
- (1) diameter (inches) 1 1/4
 - (2) total depth (feet) 250
 - (3) static water level (feet) 4 ^{below} top of ground. _{above}
 - (4) casing _____ (material) _____ (depth) _____ (size) if telescope see back.
 - (5) screen 5' 245
(length) (depth to top)
1/4 Bron
(size) (material)
 - (6) pump _____ (HP) _____ (yield gpm)
_____ (type power)
 - (7) electric log no
(yes or no)
_____ (organization running log)
 - (8) how well bottom plugged BP Valve




DRILLERS REMARKS: _____

If well telescopes please sketch and show depths.

GROUND LEVEL

SE NE

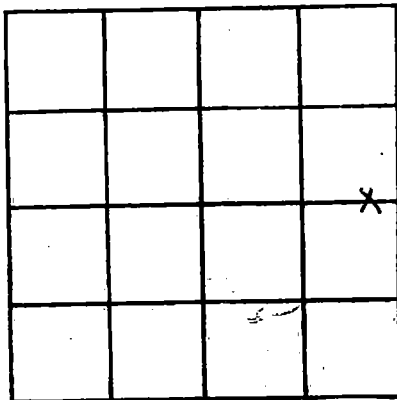

SECTION 35

Please indicate well location X.

ADDITIONAL INFORMATION

If more than one screen, show locations of each on sketch.