

49

Jackson
L 60
9-63

MISSISSIPPI
 BOARD OF WATER COMMISSIONERS
 416 North State Street
 Jackson, Mississippi 39201

WATER WELL DRILLERS LOG

Sept 30 1963 Colville Water Supply Jackson
 date well completed firm name county well located

LANDOWNER: H. C. Miller

description of formations encountered

from to

Three Rivers Miss
 (mailing address)

clay	0	12
sand	12	126
clay	126	306
sand	306	312


WELL LOCATION:

sec. ~~23~~ T-6 N R-6 E
 5 miles N of Escatawpa
 (distance) (direction) (nearest town)

WELL PURPOSE: Home
 (home, irrigation, municipal, industrial)

WELL COMPLETION DATA:


- (1) diameter (inches) 1 1/4
- (2) total depth (feet) 312
- (3) static water level (feet) 1 below top of ground
- (4) casing (material) (depth) (size) if telescope see back.
- (5) screen 1 1/4 307 (length) (depth to top) (size) (material)
- (6) pump (HP) (yield gpm) (type power)
- (7) electric log no (yes or no) (organization running log)
- (8) how well bottom plugged B.P. Order

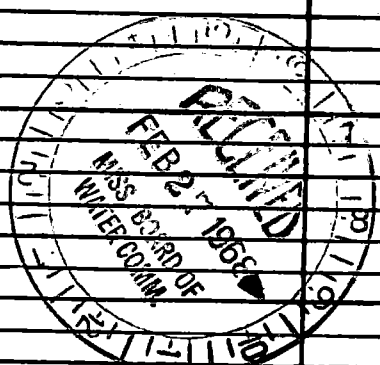

DRILLERS REMARKS:

If well telescopes please sketch and show depths.

GROUND LEVEL

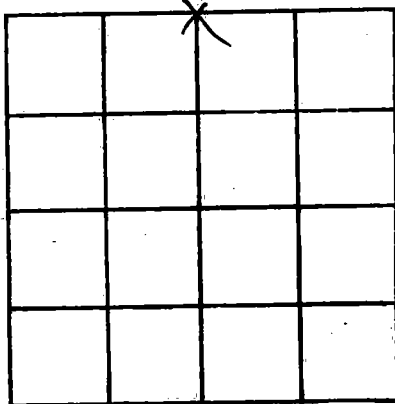

SECTION 23

Please indicate well location X.

ADDITIONAL INFORMATION

If more than one screen, show locations of each on sketch.