

JACKSON  
L 61  
7-64

MISSISSIPPI  
BOARD OF WATER COMMISSIONERS  
416 North State Street  
Jackson, Mississippi 39201

WATER WELL DRILLERS LOG

July 1 1964 Corbett Water Supply Jackson  
date well completed firm name county well located

LANDOWNER: Louis Sadrius  
Mass Point, Miss  
(mailing address)

description of formations encountered	from to	
	ft	ft
Clay	0	42
sand	42	63
Clay	63	189
sand	189	215

WELL LOCATION:  
sec. 39 T 6 N R 6 E  
3 1/3 miles SE of Wadley  
(distance) (direction) (nearest town)

WELL PURPOSE: Camp  
(home, irrigation, municipal, industrial)

- WELL COMPLETION DATA:
- (1) diameter (inches) 2"
  - (2) total depth (feet) 215
  - (3) static water level (feet) 4  below  above top of ground.
  - (4) casing galv. 210  
(material) (depth)
  - \_\_\_\_\_ if telescope see back.  
(size)
  - (5) screen 5' 210  
(length) (depth to top)
  - 2 stainless  
(size) (material)
  - (6) pump \_\_\_\_\_ (HP) \_\_\_\_\_ (yield gpm)
  - \_\_\_\_\_ (type power)
  - (7) electric log no  
(yes or no)
  - \_\_\_\_\_ (organization running log)
  - (8) how well bottom plugged By skip


MAY 27 1968

MISS. BOARD OF  
WATER COMM.

DRILLERS REMARKS: Pump & screen (homemade) furnished by owner

If well telescopes please sketch and show depths.

GROUND LEVEL

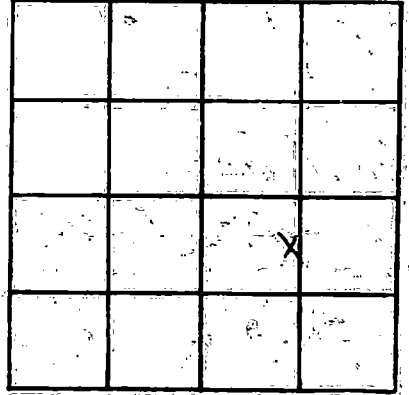

SECTION 39

Please indicate well location X.

ADDITIONAL INFORMATION

If more than one screen, show locations of each on sketch.