

JACKSON
 L 63
 10-64

MISSISSIPPI
 BOARD OF WATER COMMISSIONERS
 416 North State Street
 Jackson, Mississippi 39201

WATER WELL DRILLERS LOG

Oct 6 1964 Colville Water Supply Jackson
 date well completed firm name county well located

LANDOWNER: Tom McMillian
Woodchase Office
 (mailing address)

description of formations encountered	from	to
	yellow clay	0
blue clay and sandstone	30	78
sand	78	89

WELL LOCATION:
 sec. 39 T. 6 N. R. 6 E. S. 1 W.
3 1/2 miles SE of Woodchase
 (distance) (direction) (nearest town)

WELL PURPOSE: home
 (home, irrigation, municipal, industrial)

WELL COMPLETION DATA:
 (1) diameter (inches) 2
 (2) total depth (feet) 89
 (3) static water level (feet) 18 below above top of ground.
 (4) casing galv. 84
 (material) (depth)
 (size) If telescope see back.
 (5) screen 5 84
 (length) (depth to top)
2" plastic
 (size) (material)
 (6) pump _____ (HP) _____ (yield gpm)
 (type power) _____
 (7) electric log no
 (yes or no)


(organization running log) _____
 (8) how well bottom plugged SP valves

DRILLERS REMARKS: Pump installed by owner

MAY 27 1968
 MISS. BOARD OF
 WATER COMM.

If well telescopes please sketch and show depths.

GROUND LEVEL

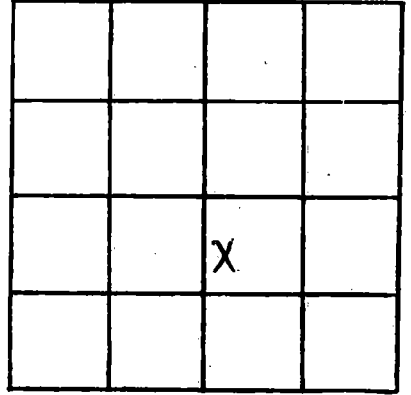

SECTION 39

Please indicate well location X.

ADDITIONAL INFORMATION

If more than one screen, show locations of each on sketch.