

0

JACKSON  
L 68  
3-10-66

MISSISSIPPI  
BOARD OF WATER COMMISSIONERS  
416 North State Street  
Jackson, Mississippi 39201

CODED

WATER WELL DRILLERS LOG

March 10 1966 Colville Water Supply Jackson  
date well completed firm name county well located

LANDOWNER: Cecil  
Mc Kee  
Hickory Hill & State  
(mailing address)

description of formations encountered	from	to
Clay	0	20
Sand	20	80
Clay	80	154
Sand	154	210
Clay	210	264
Sand	264	272
Clay	272	324
Sand	324	352
Clay and fine sand	352	586
54 rocks	586	616
Sand	616	644

WELL LOCATION:  
In: sec. 7 T. 6 N. R. 6 E.  
7 1/2 miles N. of Lumberton  
(distance) (direction) (nearest town)

WELL PURPOSE: Dom  
(home, irrigation, municipal, industrial)


WELL COMPLETION DATA:  
(1) diameter (inches) 2"  
(2) total depth (feet) 644  
(3) static water level (feet) 6 below above top of ground.  
(4) casing Galv. 636 (material) (depth)  
(size) If telescope see back.  
(5) screen 8' 636 (length) (depth to top)  
2" Stainless (size) (material)  
(6) pump 1 12 (HP) (yield gpm)  
Elec (type power)  
(7) electric log no (yes or no)  
(organization running log)  
(8) how well bottom plugged Valve BP

MAR 20 1966  
MISS. Bd. OF WATER COM.

DRILLERS REMARKS:

If well telescopes please sketch and show depths.

GROUND LEVEL

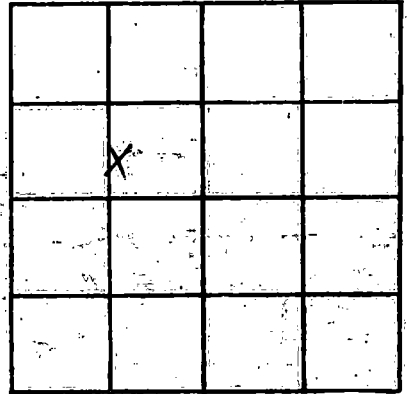

*Irregular*  
SECTION \_\_\_\_\_

Please indicate well location X.

ADDITIONAL INFORMATION

If more than one screen, show locations of each on sketch.