

Jackson
L 70
12-16-65

MISSISSIPPI
BOARD OF WATER COMMISSIONERS **CODED**
416 North State Street
Jackson, Mississippi 39201

WATER WELL DRILLERS LOG

Dec. 16 1965 Colville Water Supply Jackson
date well completed firm name county well located

LANDOWNER: A. S. Andrie
Spring Acres
(mailing address)


description of formations encountered	from	to
	Clay sand	0 15

WELL LOCATION:
sec. 25 T. 6 N. R. 6 E.
4 miles North of MS
(distance) (direction) (nearest town)

WELL PURPOSE: home
(home, irrigation, municipal, industrial)


- WELL COMPLETION DATA:
- (1) diameter (inches) 1 1/4
 - (2) total depth (feet) 70
 - (3) static water level (feet) 8 below above top of ground.
 - (4) casing galv (material), (depth),
If telescope see back.
(size)
 - (5) screen 4', 6' (length), (depth to top)
1 1/4, Stainless (size), (material)
 - (6) pump (HP) (yield gpm)
(type power)
 - (7) electric log no (yes or no)
(organization running log)
 - (8) how well bottom plugged BPU

DRILLERS REMARKS: Pump installed by other

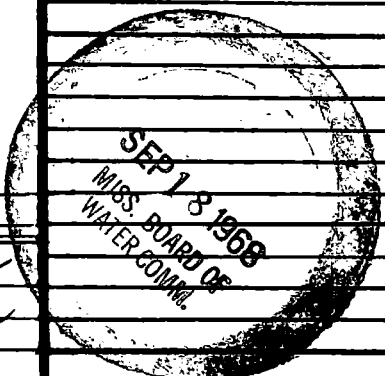

If well telescopes please sketch and show depths.

GROUND LEVEL

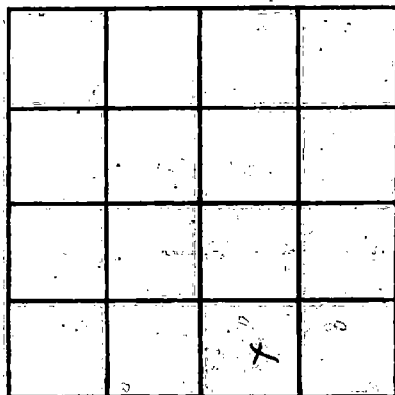

SECTION 25

Please indicate well location X.

ADDITIONAL INFORMATION

If more than one screen, show locations of each on sketch.