

Jackson
L 71
6-10-65

MISSISSIPPI
BOARD OF WATER COMMISSIONERS
416 North State Street
Jackson, Mississippi 39201

CODED

WATER WELL DRILLERS LOG

June 10 1965 Levell Water Sup Jackson
date well completed firm name county well located

LANDOWNER:
Young
Greenville Miss
(mailing address)

description of formations encountered	from	to
Clay	0	50
Sand	50	60

WELL LOCATION:
sec 35 T 6 N R 6 E
6 miles North of M.P.
(distance) (direction) (nearest town)

WELL PURPOSE: Home
(home, irrigation, municipal, industrial)

WELL COMPLETION DATA:

(1) diameter (inches) 1 1/4

(2) total depth (feet) 60

(3) static water level (feet) 40 ^{below} above top of ground.


(4) casing Galv (material) (depth) _____
(size) if telescope see back.

(5) screen 5' 55
(length) (depth to top)
1 1/4 Copper Gauge
(size) (material)

(6) pump _____ (HP) _____ (yield gpm)
(type power) _____

(7) electric log no (yes or no)
(organization running log) _____


(8) how well bottom plugged DP Valve

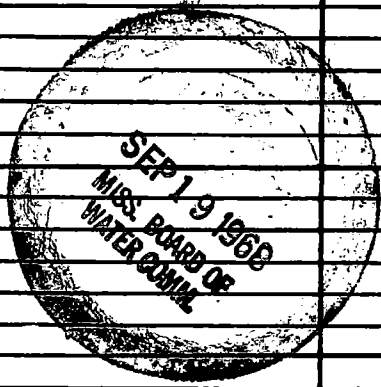

DRILLERS REMARKS: Pump installed by owner

If well telescopes please sketch and show depths.

GROUND LEVEL

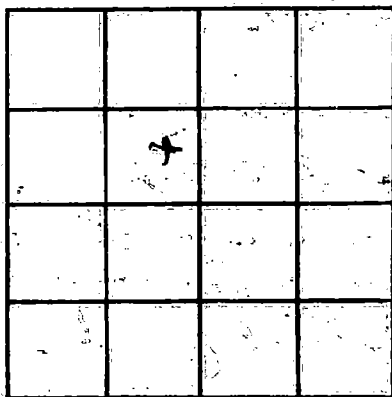

SECTION 35

Please indicate well location X.

ADDITIONAL INFORMATION

If more than one screen, show locations of each on sketch.