

CODED

Jackson
L73
3-29-67

MISSISSIPPI
BOARD OF WATER COMMISSIONERS
416 North State Street
Jackson, Mississippi 39201

WATER WELL DRILLERS LOG

March 29 1967 well completed
Coble Water Sys firm name
Jackson county well located

LANDOWNER: <u>H.H. Robbins</u>	description of formations encountered		from	to
<u>Three Rivers</u> (mailing address)	<u>clay</u>		<u>0</u>	<u>21</u>
	<u>sand</u>		<u>21</u>	<u>122</u>
	<u>clay</u>		<u>122</u>	<u>442</u>
	<u>sand</u>		<u>142</u>	<u>156</u>
	<u>clay</u>		<u>156</u>	<u>428</u>
	<u>sand</u>		<u>428</u>	<u>447</u>
WELL LOCATION: sec <u>11</u> T <u>6</u> N R <u>6</u> E <u>8</u> miles <u>North</u> of <u>M.P.</u> (distance) (direction) (nearest town)				
WELL PURPOSE: <u>home</u> (home, irrigation, municipal, industrial)				
WELL COMPLETION DATA:				
(1) diameter (inches) <u>2"</u>				
(2) total depth (feet) <u>447</u>				
(3) static water level (feet) <u>10</u> <u>below</u> <u>above</u> top of ground.				
(4) casing <u>galv</u> (material) (depth)				
(size) if telescope see back.				
(5) screen <u>5'</u> <u>442</u> (length) (depth to top)				
<u>2</u> <u>stainless</u> (size) (material)				
(6) pump <u>1/2</u> <u>7</u> (HP) (yield gpm)				
<u>elec</u> (type power)				
(7) electric log <u>no</u> (yes or no)				
(organization running log)				
(8) how well bottom plugged <u>BPC value</u>				


APR 21 1967

MISS. BD. OF
WATER COMM.

DRILLERS REMARKS:

If well telescopes please sketch and show depths.

GROUND LEVEL

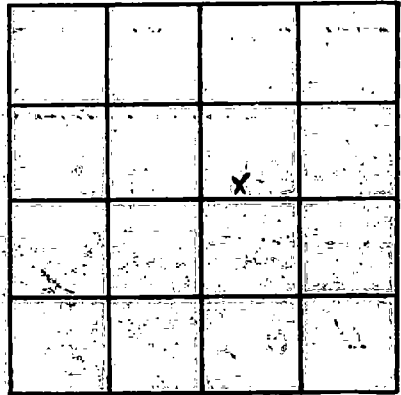

SECTION 11

Please indicate well location X.

ADDITIONAL INFORMATION

If more than one screen, show locations of each on sketch.